


T.22S.R.31E.W.M.

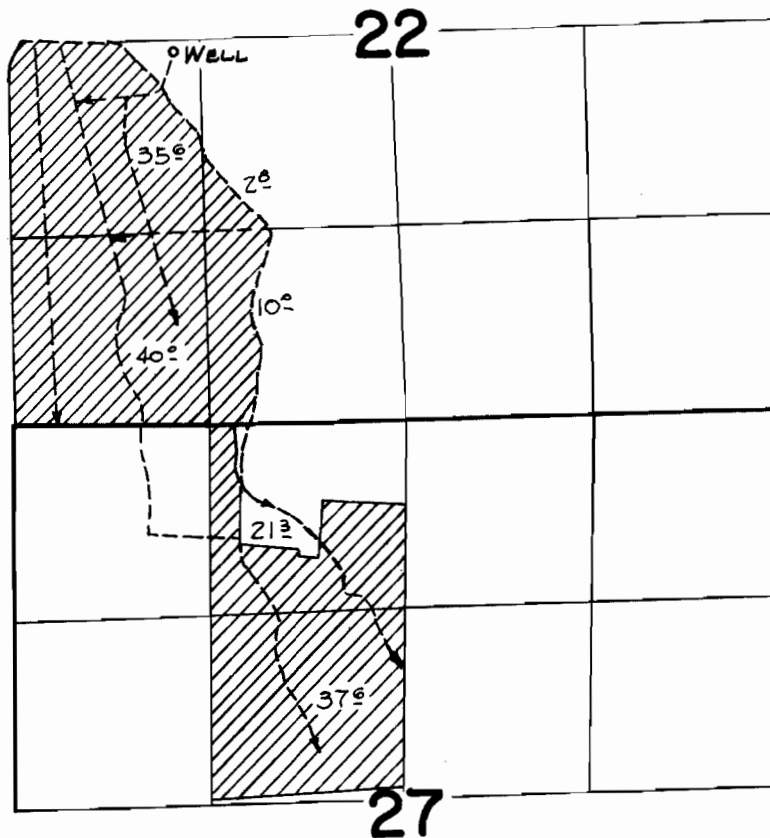

FINAL PROOF SURVEY
UNDER

Application No. G-189 Permit No. G-105
IN NAME OF

C. W. CLEMENS

Surveyed SEPT. 14, 1963, by C. D. BAKER

Rf