


T.38&39S.R.33E.W.M.

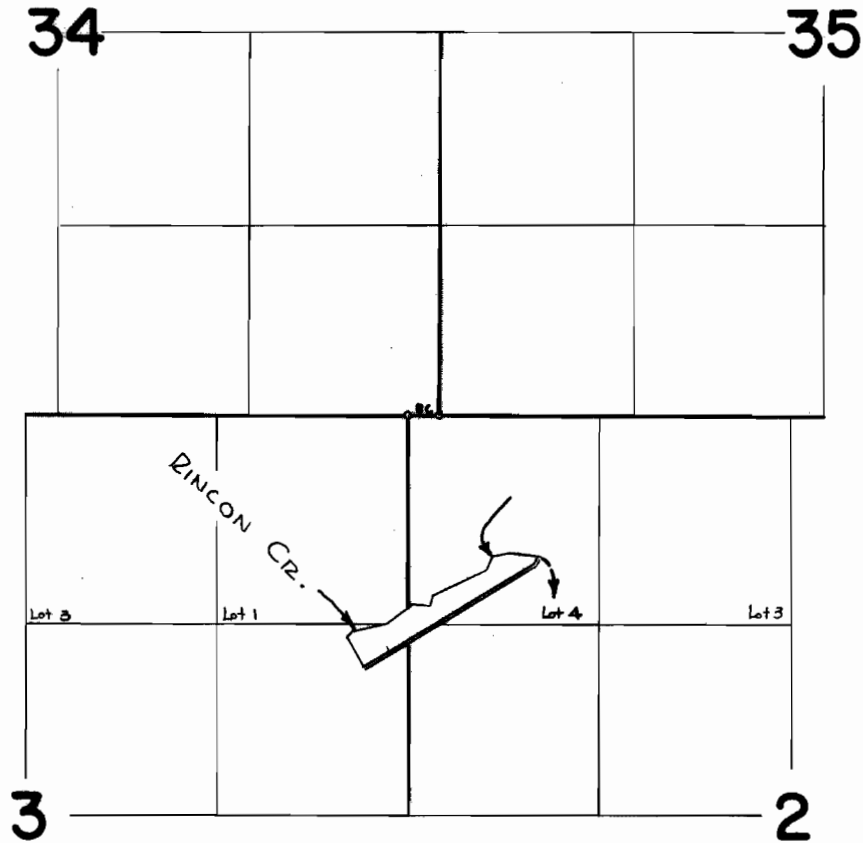

FINAL PROOF SURVEY

UNDER

Application No. D-23047 Permit No. D-928
IN NAME OF 18180

ESTELLA CALDERWOOD

Surveyed Aug. 22 1963, by C. R. BAKER