T.25&26R.28E.W.M.

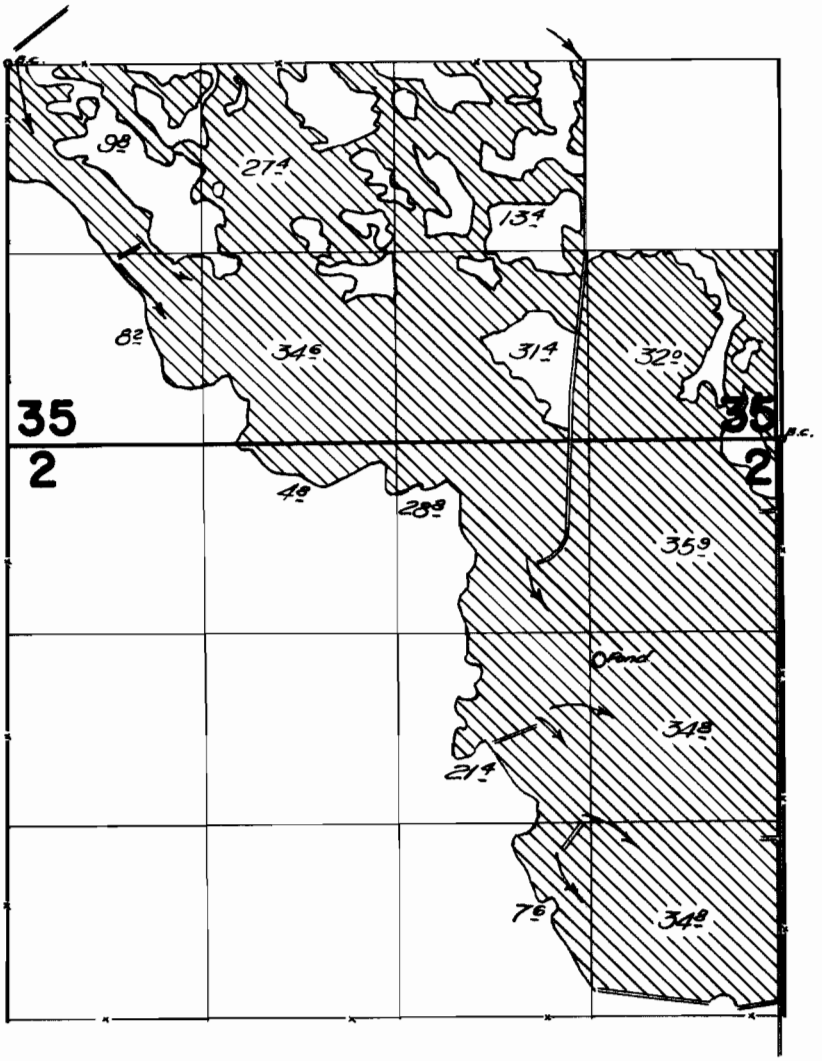

FINAL PROOF SURVEY
UNDER

Application No. 27047 Permit No. 21284
IN NAME OF

LOUIS YRIARTE

Surveyed Sept. 17 1963, by R. Gleason

EFI-IDY-152
11V-5