


T.23 S. R. 32 E. W.M.

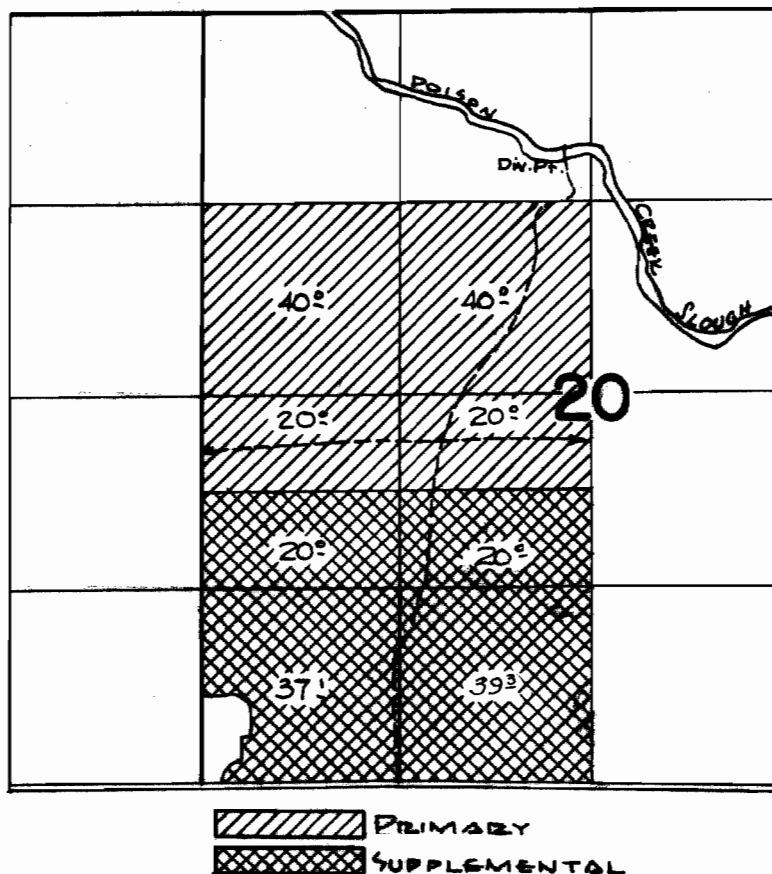

FINAL PROOF SURVEY
UNDER

Application No. 32191..... Permit No. 25392.
IN NAME OF

CLYDE & HENRY COWING

Surveyed SEPT. 16 1903, by C. R. BAKER