


T.37S.R.2W.W.M.

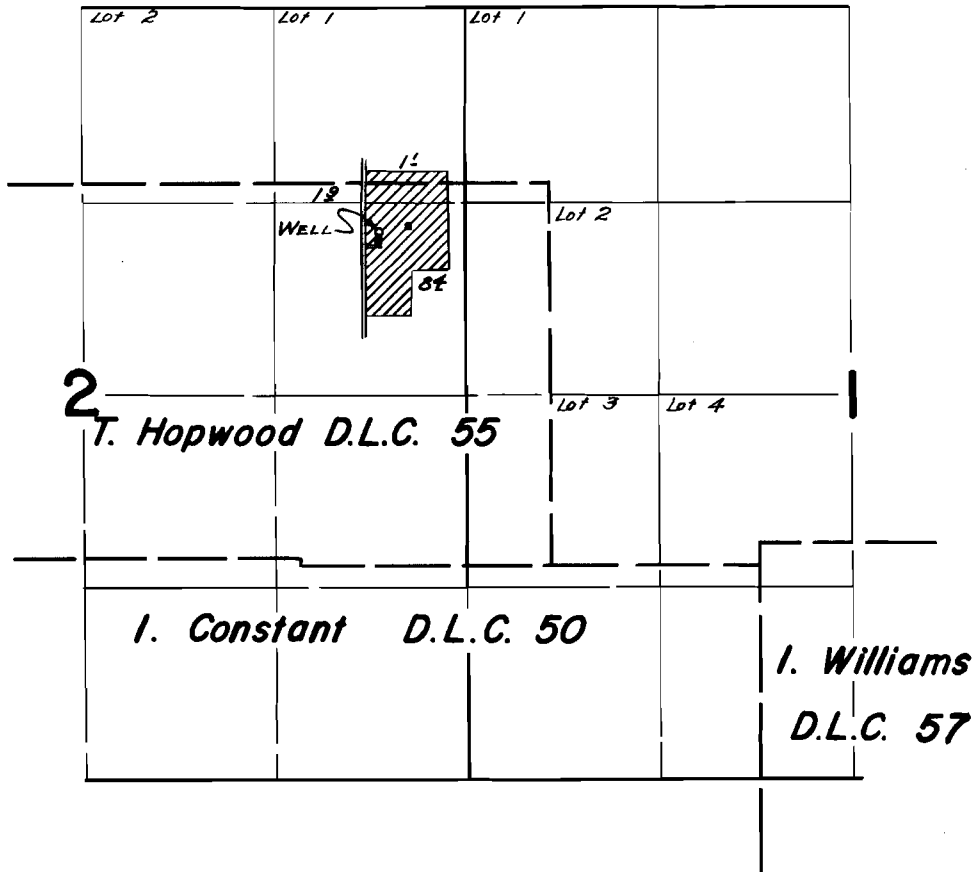

FINAL PROOF SURVEY UNDER

Application No. G-1605 Permit No. G-1489
IN NAME OF

RAY W. ANDERS

Surveyed May 14 1963, by A. Jackson