


T.36S.R.2 W.W.M

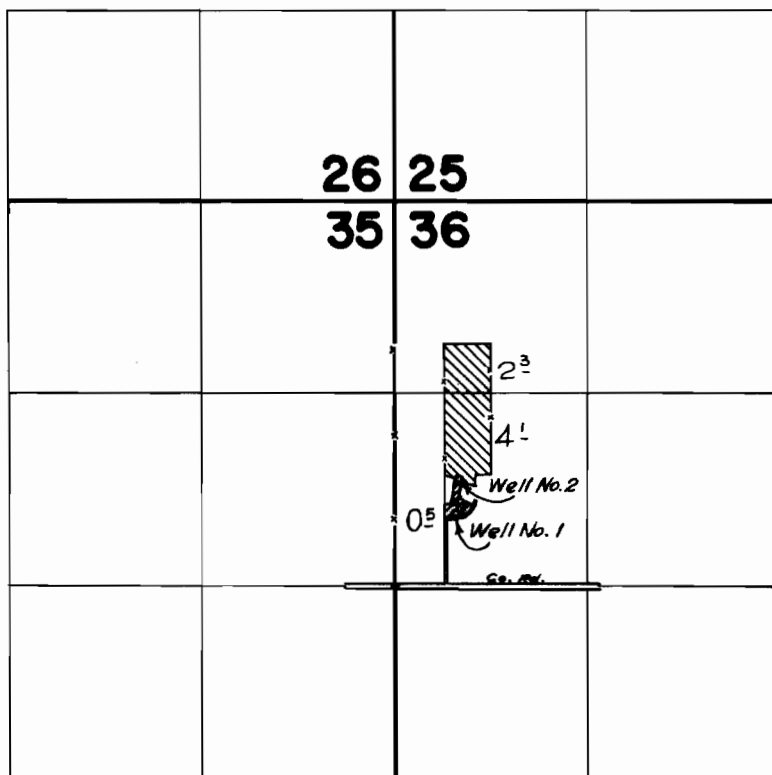

FINAL PROOF SURVEY UNDER

Application No. 6-1745.. Permit No. G-1596...
IN NAME OF

RUTH M. CLEMMER

Surveyed May 15, 1963, by *[Signature]*