


T.37S.R.IW.W.M.

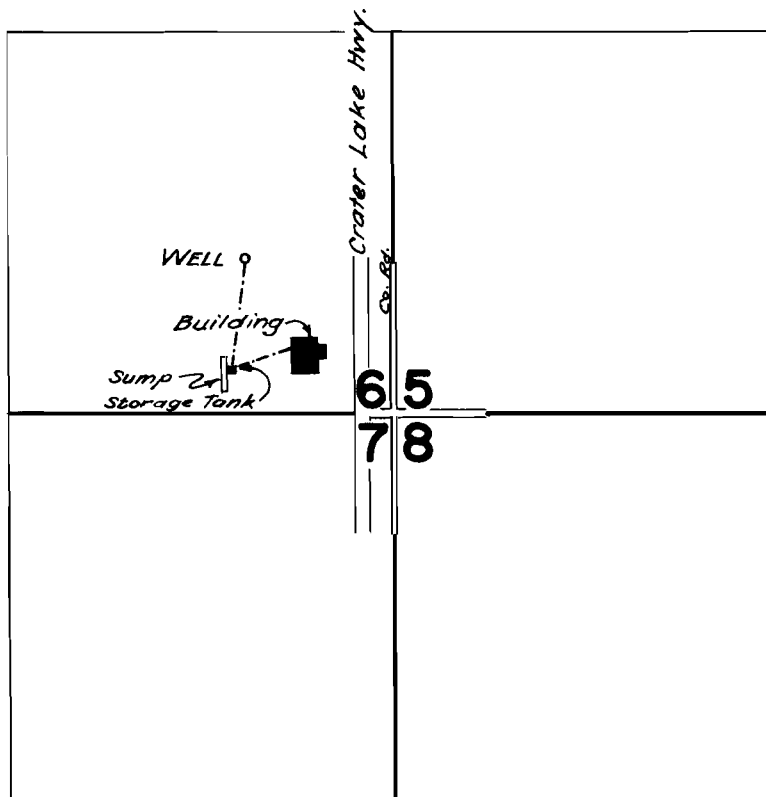

Scale: 1" = 660'

FINAL PROOF SURVEY UNDER

Application No. G-1694 Permit No. G-1737
IN NAME OF

CUMMINS DIESEL OF MEDFORD, INC.

Surveyed May 14, 1963, by *Alfredson*