


T.37S.R.3E.W. M.

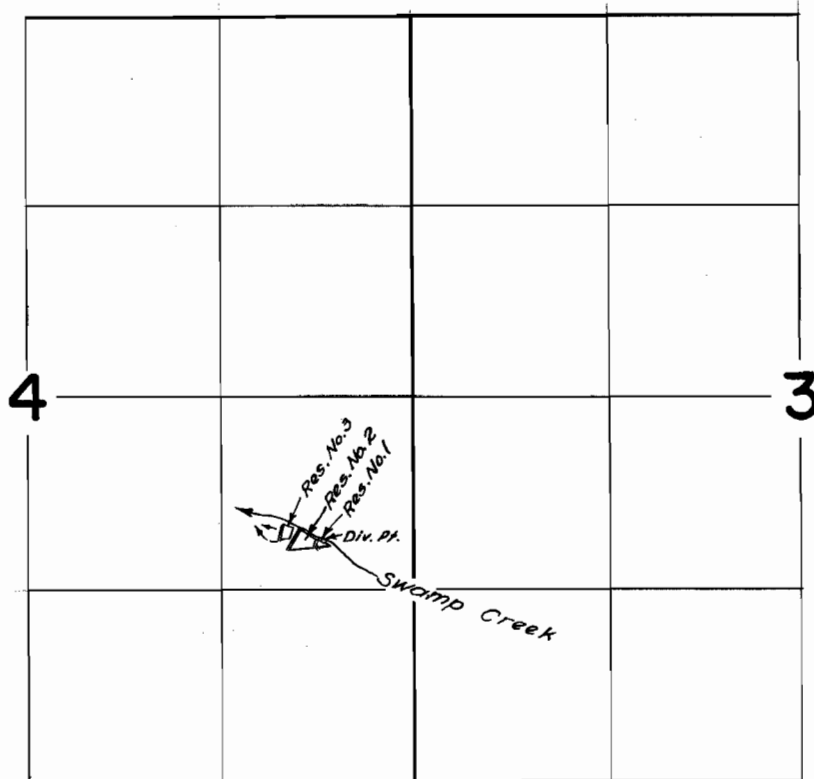

FINAL PROOF SURVEY
UNDER

R-30873 **R-1891**
Application No. **30874** Permit No. **24328**
IN NAME OF

IRVING W. FREY

Surveyed May 21, 1963, by *R. J. Peterson*