


T.35 S.R.1 W.W.M.

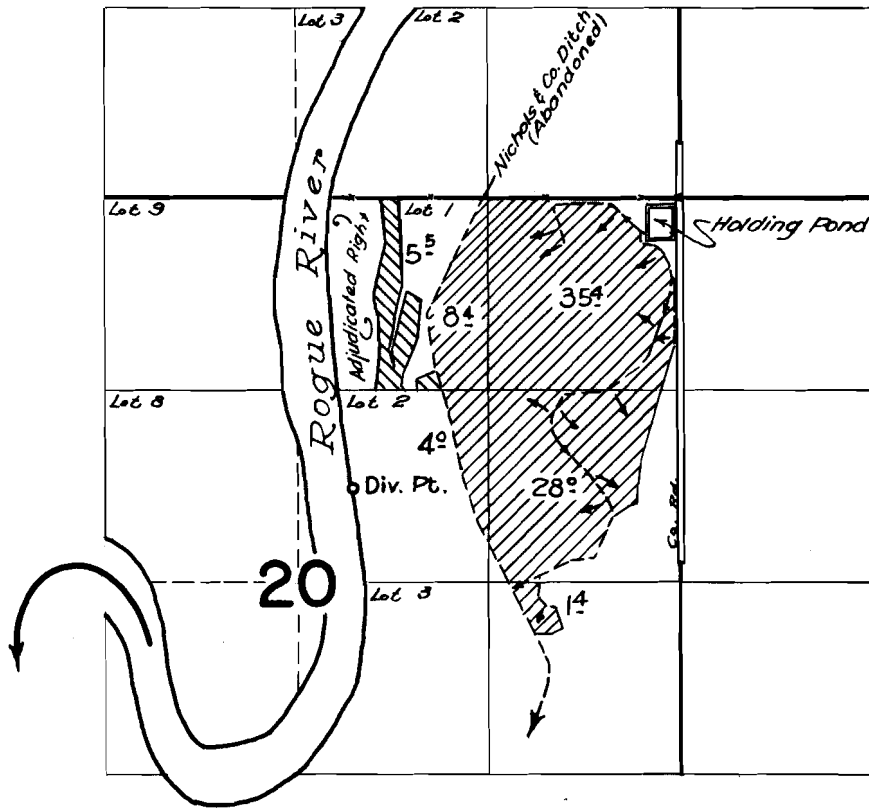

 32439

 32849

FINAL PROOF SURVEY
UNDER

Application No. **32439**... Permit No. **25606**
32849... Permit No. **25948**...
IN NAME OF

GEORGE H. JESS

Surveyed May 22:23 1963, by

