


T.35 S.R.1 W.W.M.

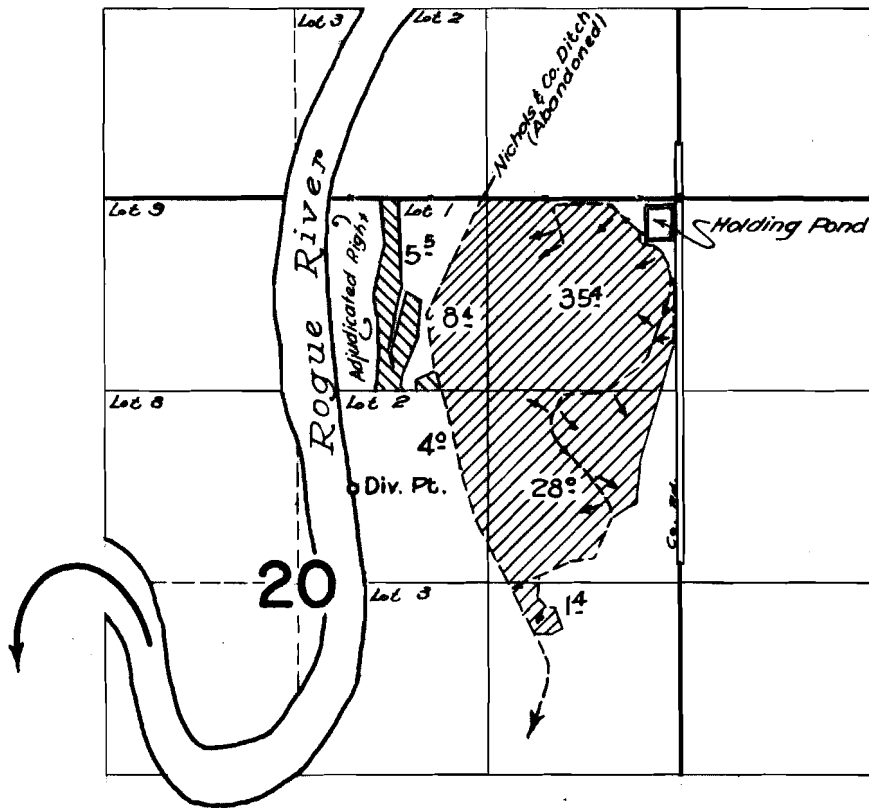

 32439

 32849

FINAL PROOF SURVEY UNDER


Application No. **32439**... Permit No. **25606**
~~32849~~... ~~25948~~...
IN NAME OF

GEORGE H. JESS

Surveyed May. 22-23 1963, by



T.35 S.R.1 W.W.M.

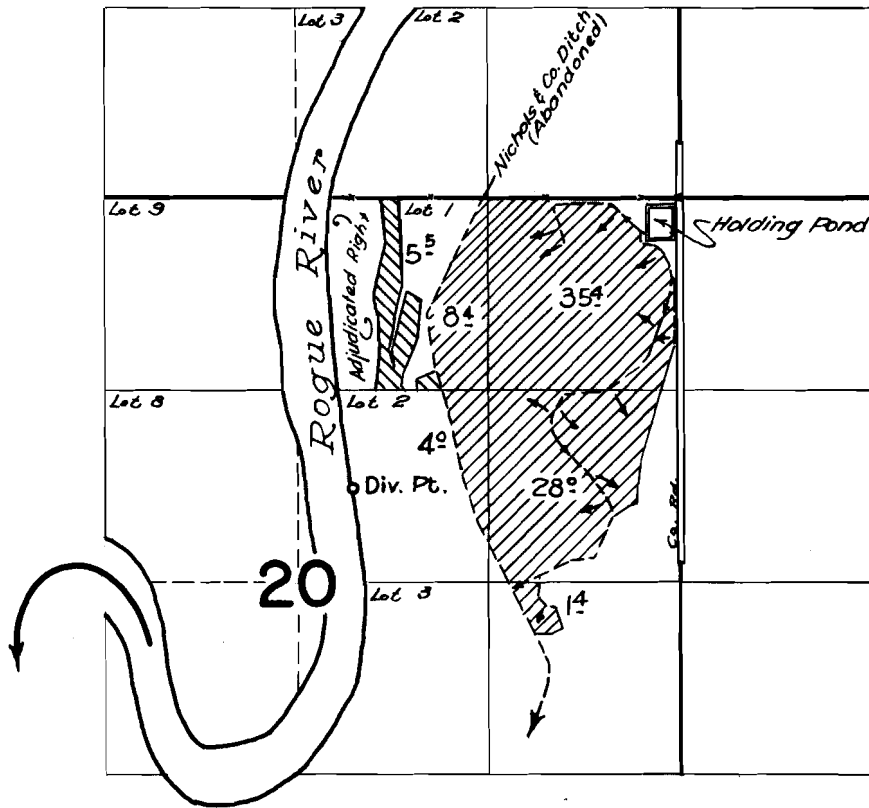

 32439

 32849

FINAL PROOF SURVEY UNDER

Application No. **32439**... Permit No. **25606**
32849... Permit No. **25948**...
IN NAME OF

GEORGE H. JESS

Surveyed May 22:23 1963, by

