


T.32S.R.3E.W.M.

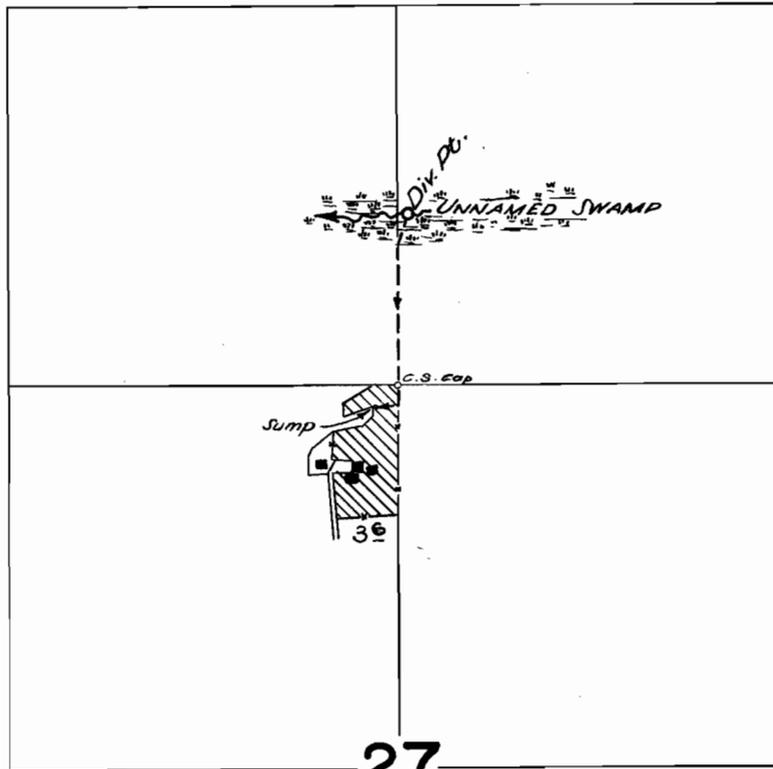

27
Scale: 1" = 660'

FINAL PROOF SURVEY
UNDER

Application No. 32909 Permit No. 25980
IN NAME OF

ESTATE OF RAY MILLARD

Surveyed May 17 1963, by *Al Peterson*