


T.35S.R.3 W.W.M.

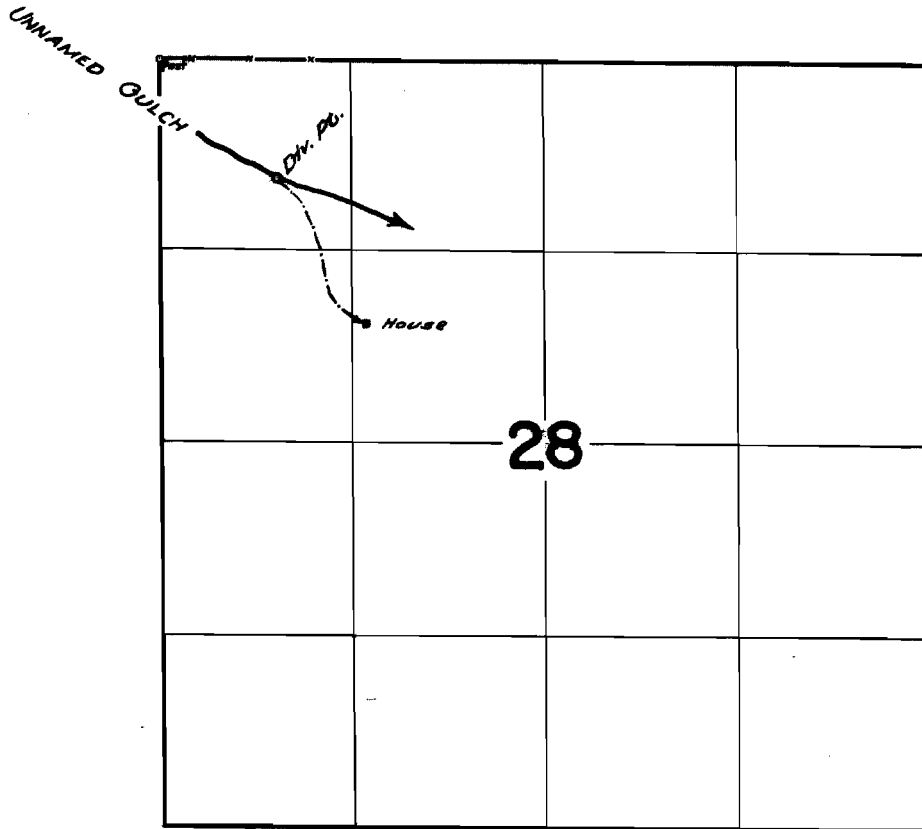

FINAL PROOF SURVEY UNDER

Application No. 33503... Permit No. 26500...
IN NAME OF

.....OLAV K. LOKKEN.....

Surveyed *May 18*, 1963, by *R. Jackson*