


T.36S.R.4W.W.M.

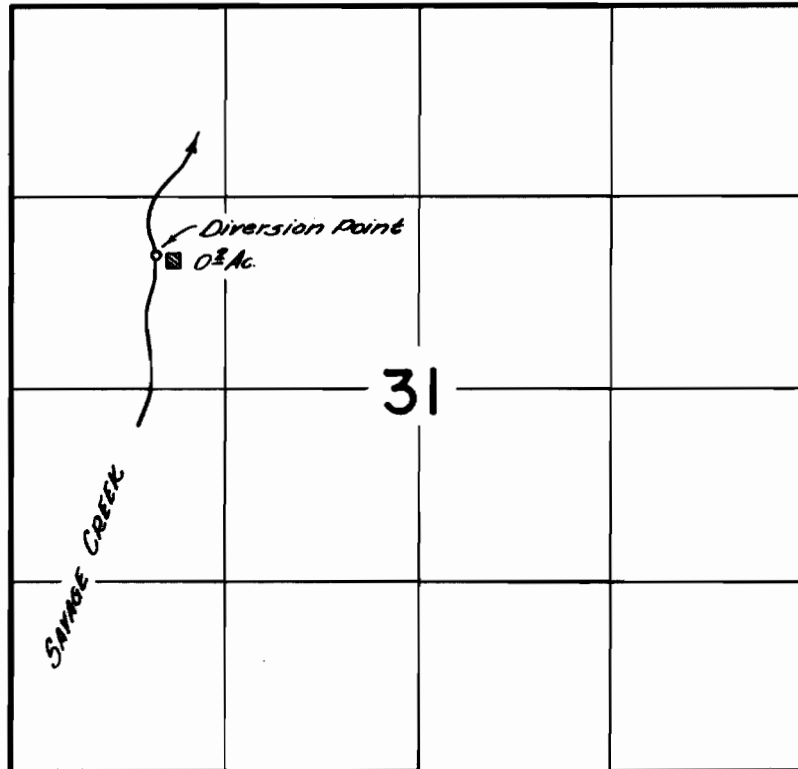

**FINAL PROOF SURVEY**  
UNDER

Application No. 342.01 Permit No. 26946  
IN NAME OF

Minnie Babb

Surveyed July 13 1963, by C. Baker