


T.36S.R.4W.W.M.

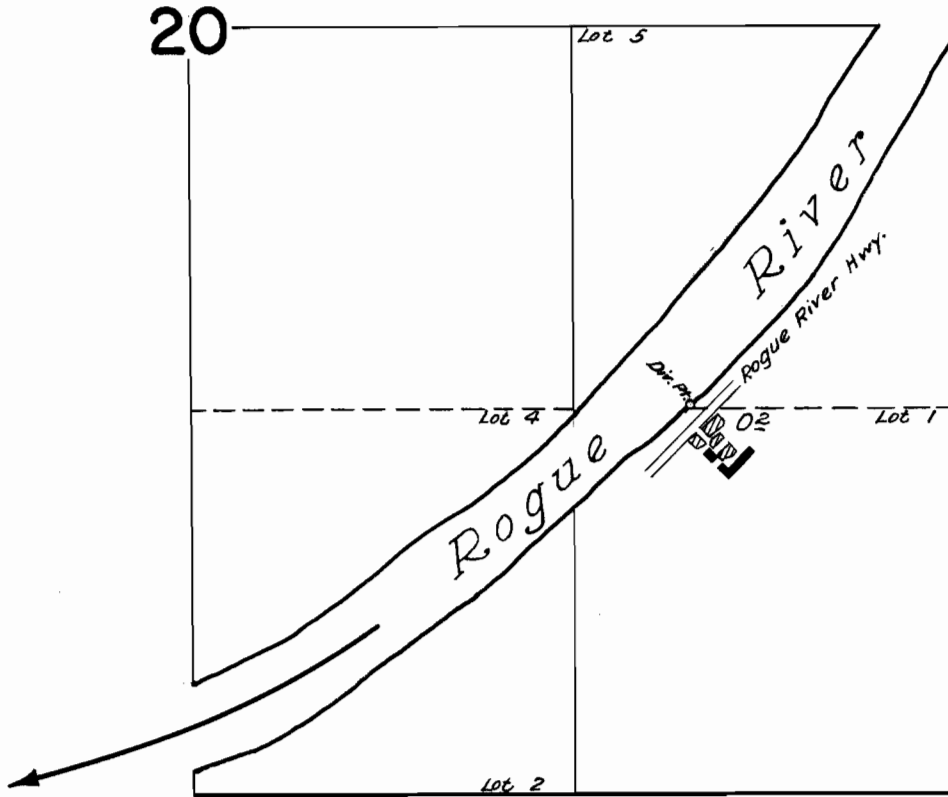

Scale : 1" = 660'

FINAL PROOF SURVEY
UNDER

Application No. 37014... Permit No. 27593...
IN NAME OF

A. J. OLIVER; ROGUE VALLEY MOTEL

Surveyed May 20 1963, by *[Signature]*