


T.36S.R.3W.W.M.

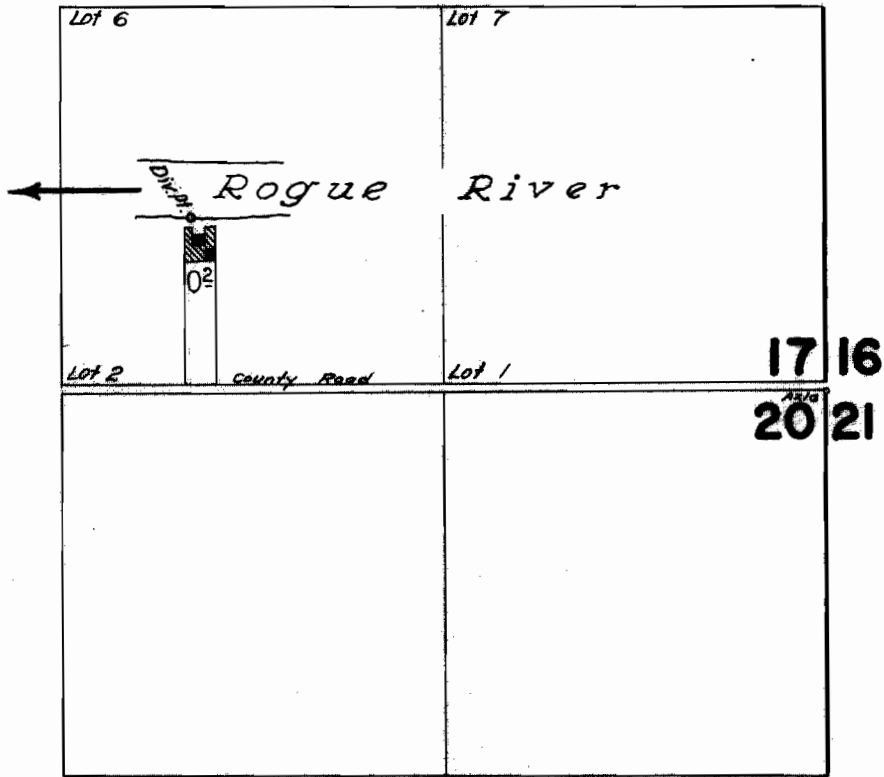

Scale: 1" = 660'

FINAL PROOF SURVEY UNDER

Application No. 35068... Permit No. 27628...

IN NAME OF

WILLIAM R. ROBERTS

Surveyed May 15, 1963, by

R. Jackson