


T.37&38S.R.5W.W.M.

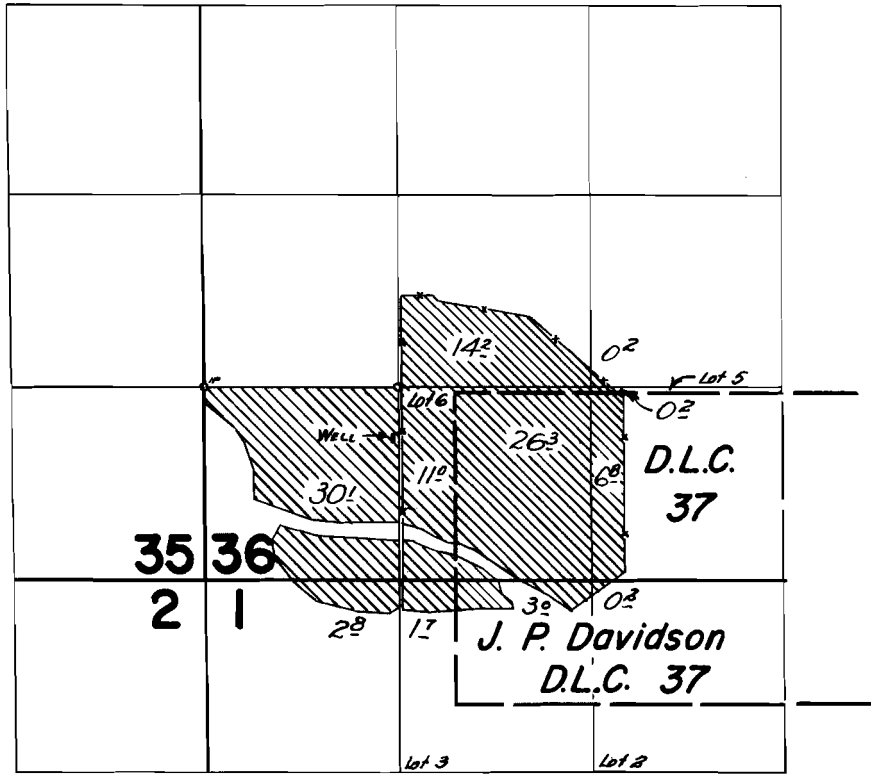

**FINAL PROOF SURVEY**  
UNDER

Application No. ~~G-1986~~ Permit No. ~~G-1828~~  
IN NAME OF

**JACK BENNETT**

Surveyed July 16 1963, by *[Signature]*