


T.37S.R.7W.W.M.

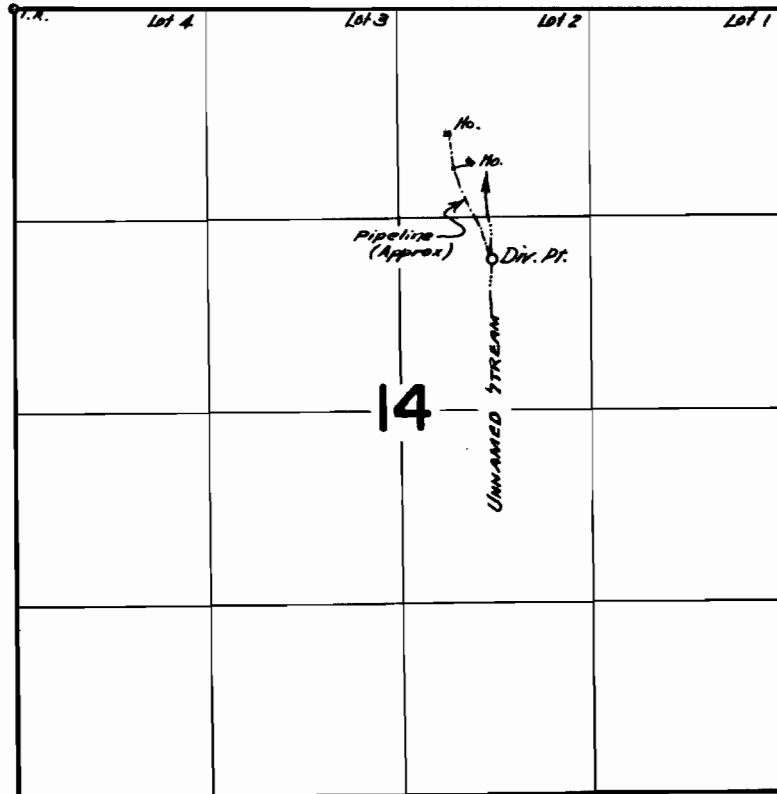

FINAL PROOF SURVEY
UNDER

Application No. 33221 Permit No. 26263
IN NAME OF

JOSEPH H. & MARIE L. KOSTENKO

Surveyed July 11, 1963, by R. Jackson