


T.36S.R.6W.W.M.

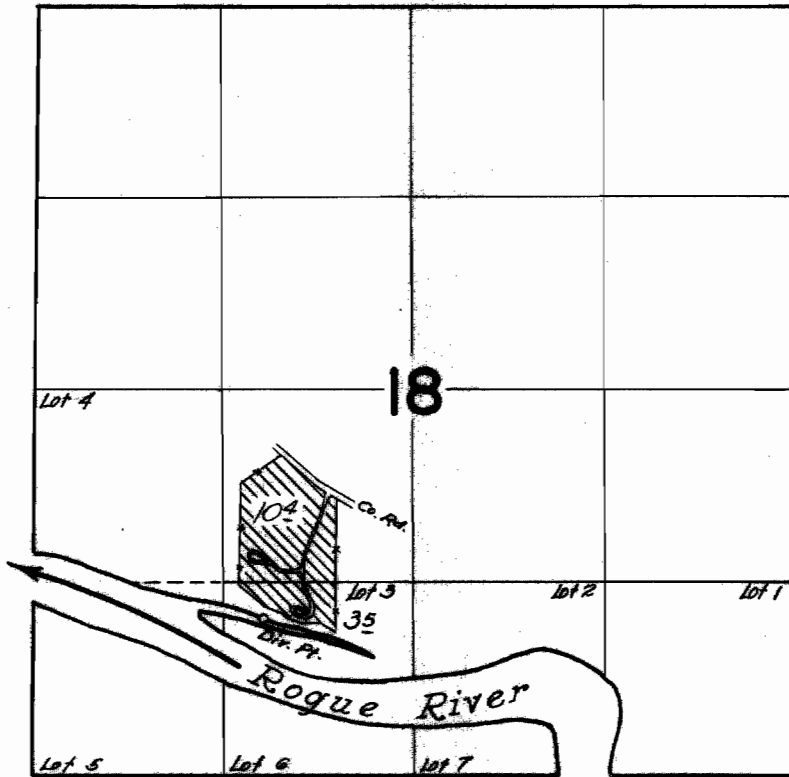

**FINAL PROOF SURVEY**  
UNDER

Application No. 34079... Permit No. 26853...  
IN NAME OF

**JOSEPHINE COUNTY COURT**

Surveyed June 4, 1963, by *A. Jackson*