


T.36S.R.6 W.W.M.

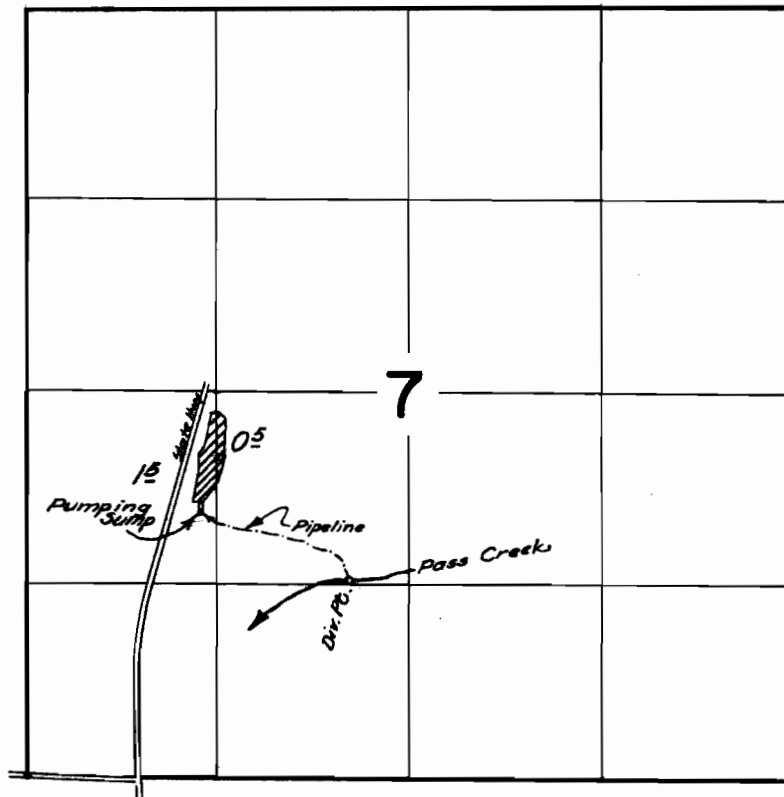

FINAL PROOF SURVEY
UNDER

Application No. 34993 Permit No. 27474
IN NAME OF

KIRK H. FOX

Surveyed July 13, 1963, by RH Jackson