


T.37S. R.7W. W.M.

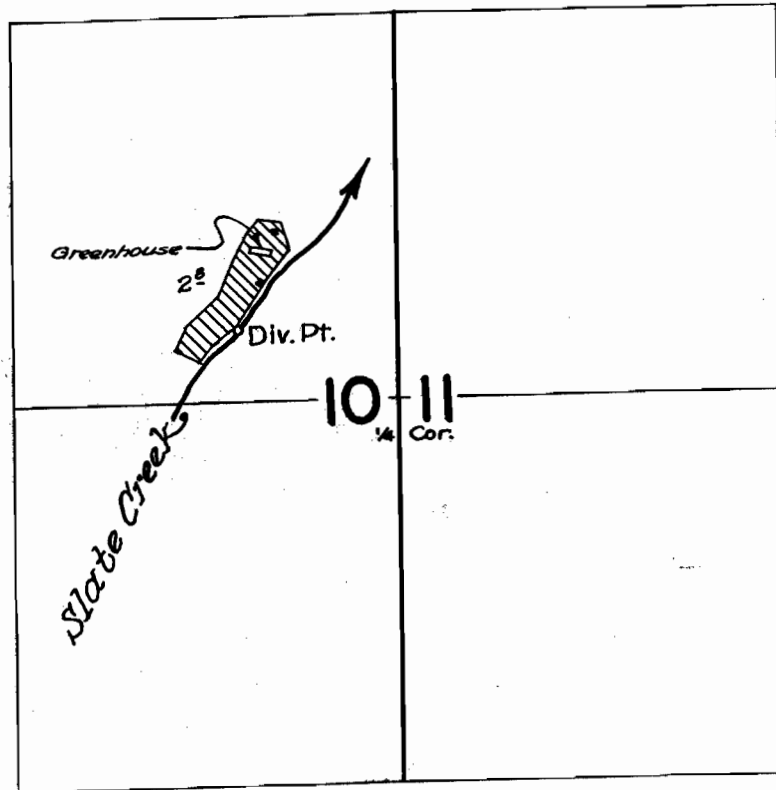

Scale · 1" = 660'

FINAL PROOF SURVEY
UNDER

Application No. 37048 Permit No. 27568
IN NAME OF

MARCELLUS P. FROST

Surveyed July 12 1963, by

R. Jackson