


T.36S.R.7W.W.M

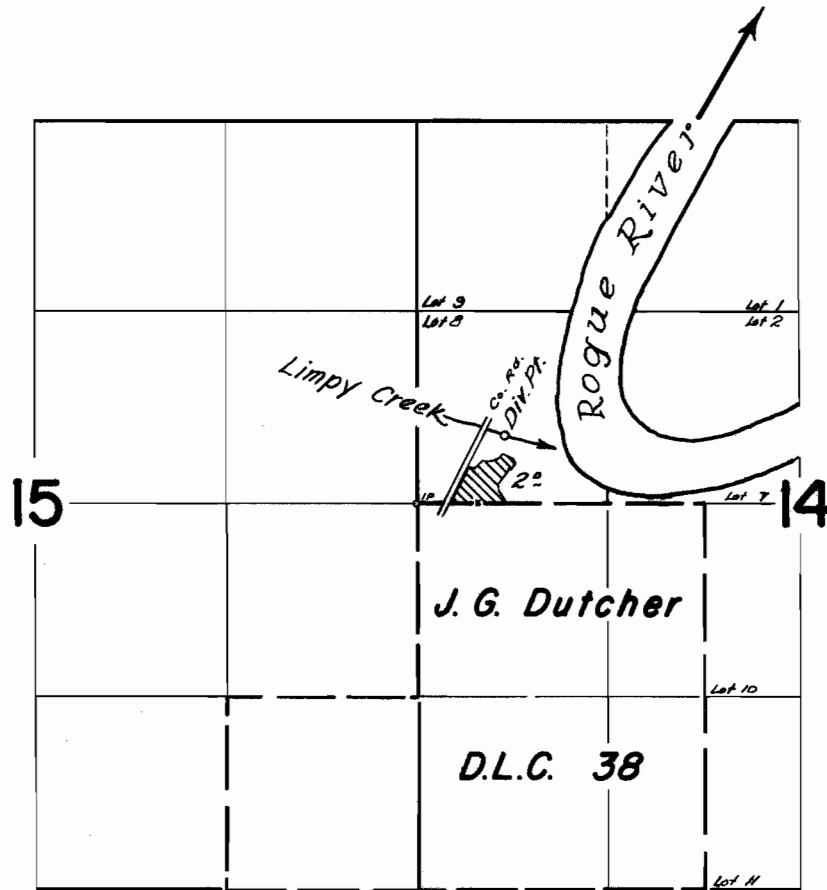

**FINAL PROOF SURVEY**  
UNDER

Application No. 37199... Permit No. 27722..  
IN NAME OF

**MAX & ETHEL NAEF**

Surveyed July 11, 1963, by *R. Jackson*