


T.36S.R.6 W.W.M.

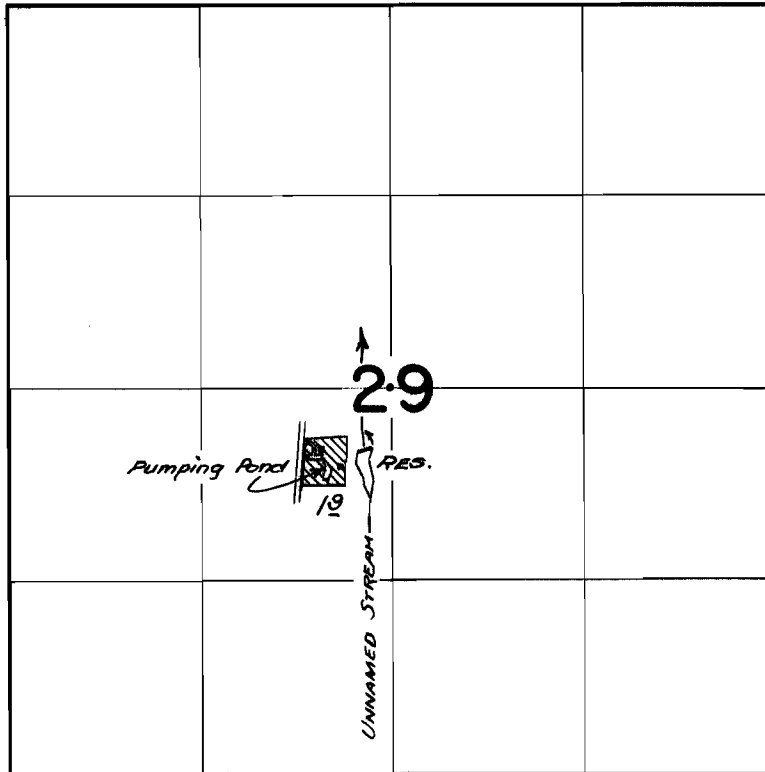

FINAL PROOF SURVEY UNDER

Application No. 37460 Permit No. 27889
IN NAME OF

ERNEST S. & BERNADINE BENNING

Surveyed July 8, 1963, by [Signature]