


T.37S. R. 6 W. W.M.

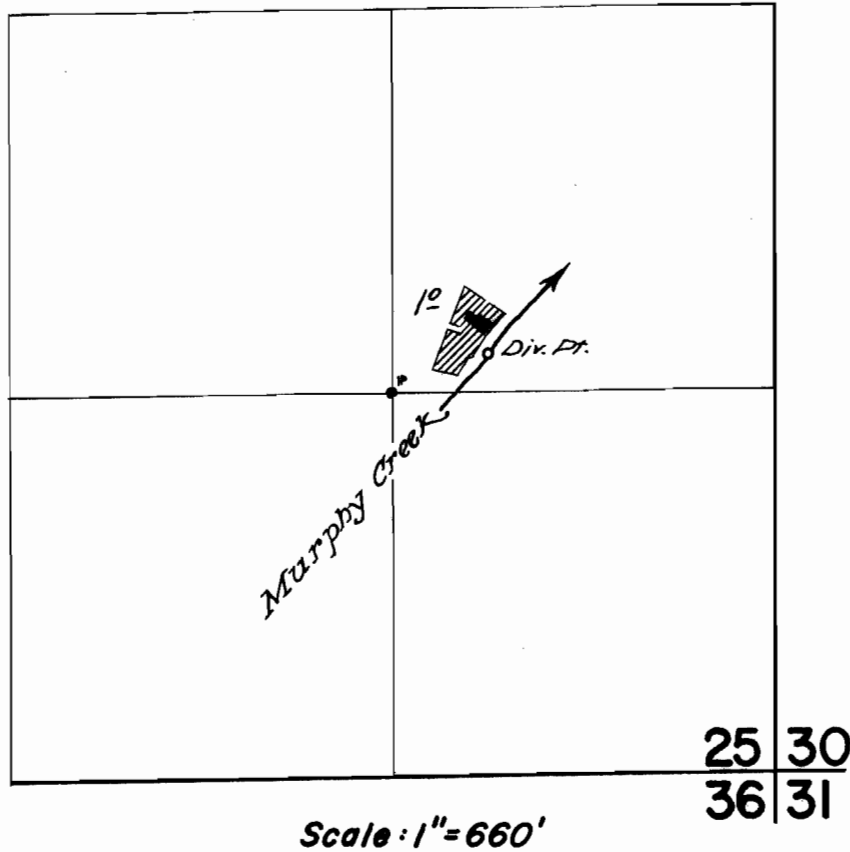

FINAL PROOF SURVEY
UNDER

Application No. 37561 Permit No. 27986
IN NAME OF

PRESLEY PYLE

Surveyed July 9, 1963, by [Signature]