


T.34S.R.6 W.W.M.

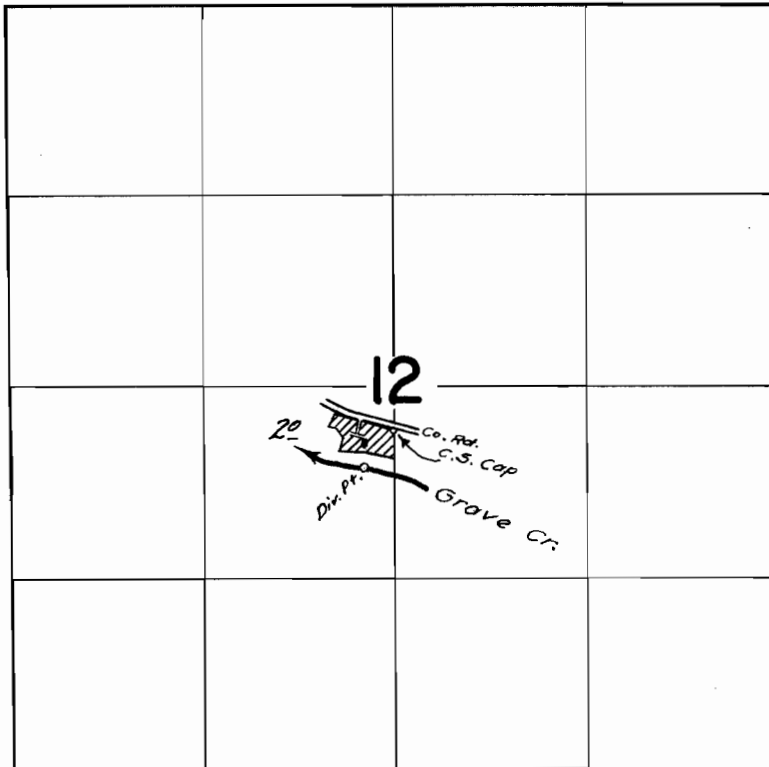

**FINAL PROOF SURVEY**  
UNDER

Application No. 37589 Permit No. 28005  
IN NAME OF

MERRILL A. RICHARDSON

Surveyed June 10, 1963, by L. A. Jackson