


T.36S.R.5 W. W.M.

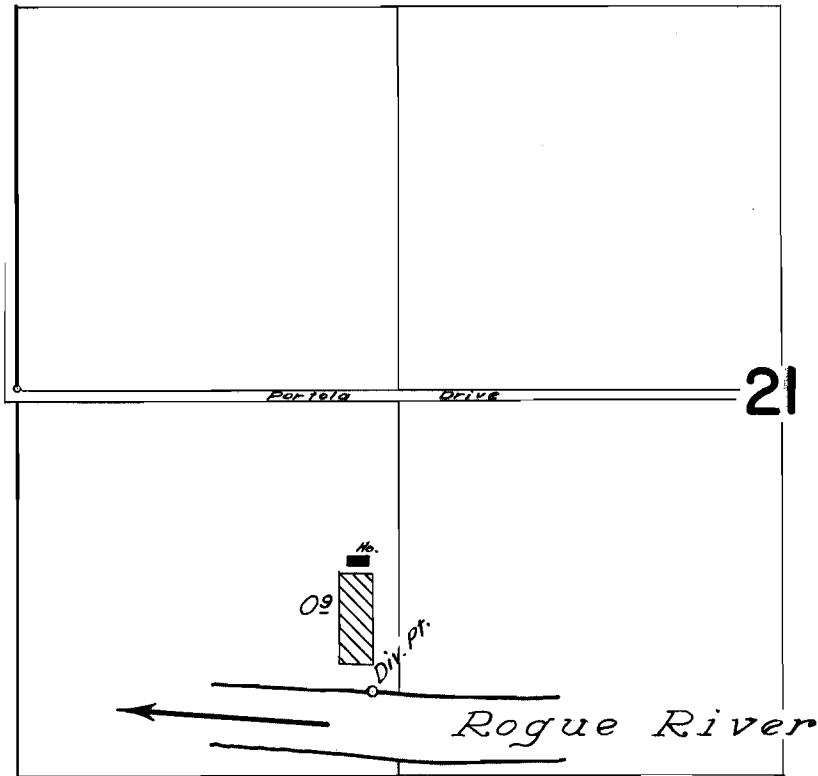

Scale : 1" = 660'

FINAL PROOF SURVEY
UNDER

Application No. 37590 Permit No. 28006
IN NAME OF

J. GIBSON PLEASANTS

Surveyed June 6, 1963, by *R. Jackson*