


T. 40S. R. 9 & 10 E.W.M.

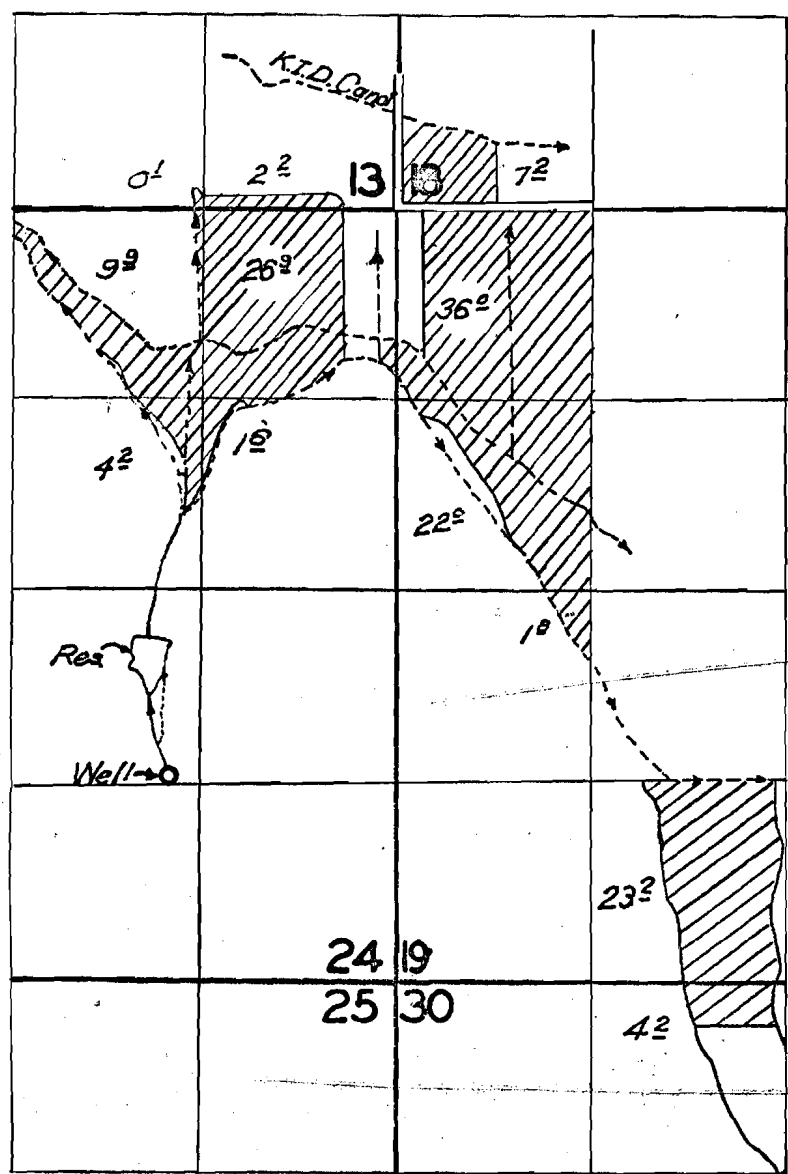

FINAL PROOF SURVEY UNDER

Application No. G-641 Permit No. G-557
IN NAME OF

Leo E. Matney

14 Aug. 1962 Carl R. Baker
Surveyed 17 Apr. 1961 by M. Bish