


T.18 S.R. 2&3 W.W.M.

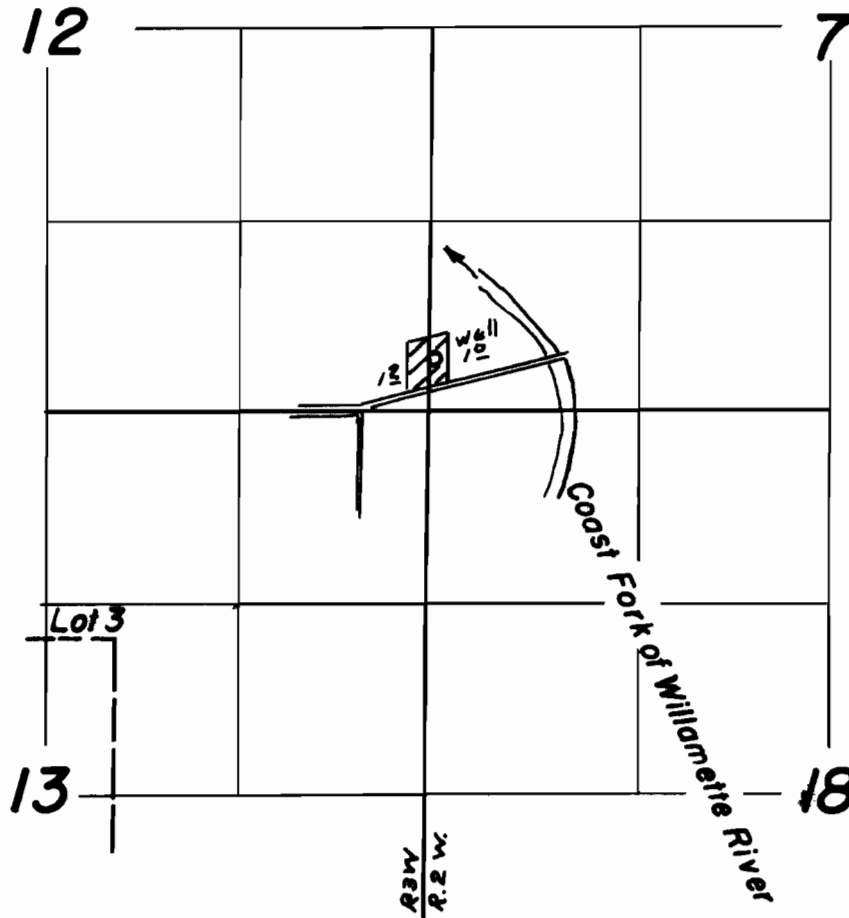

**FINAL PROOF SURVEY
UNDER**

Application No. G-1133 Permit No. G-914
IN NAME OF

Warren Holden

Surveyed May 8 1963, by T. Lauer