


T.17S.R.6 W.W.M.

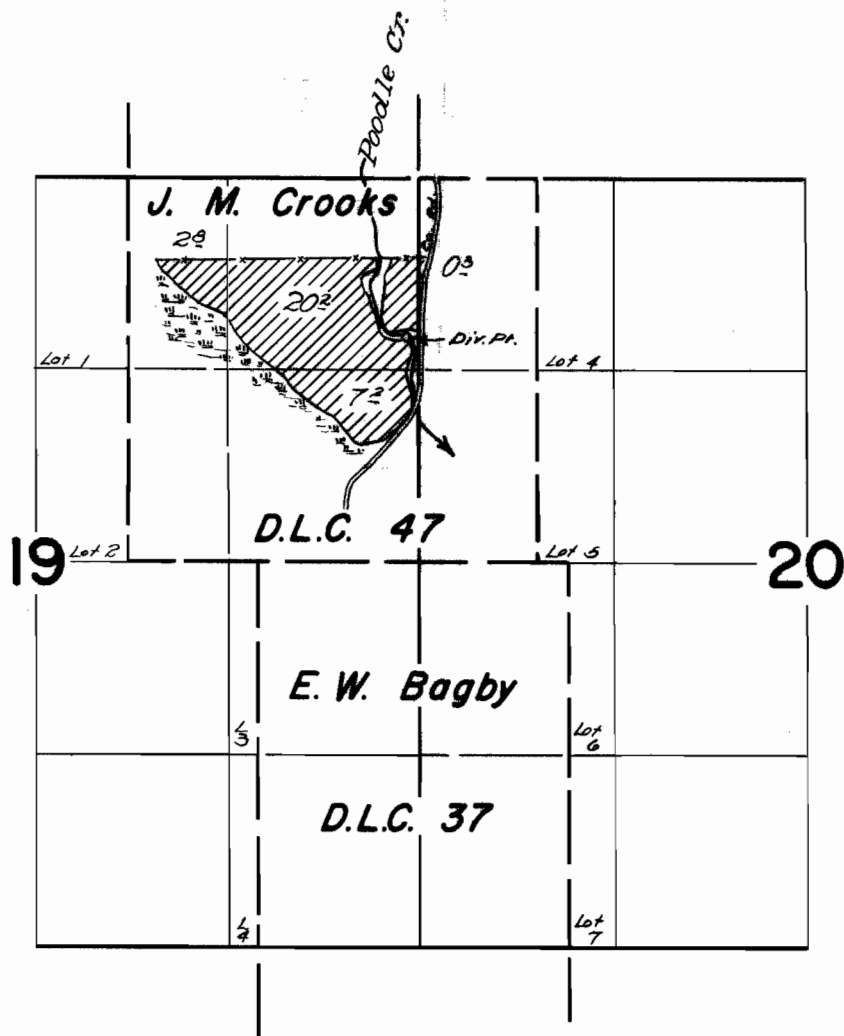

FINAL PROOF SURVEY
UNDER

Application No. 33266 Permit No. 26299
IN NAME OF

AMOS E. WEST

Surveyed May 10, 1963, by *R. H. Jackson*