


T.22S.R.3W.W.M.

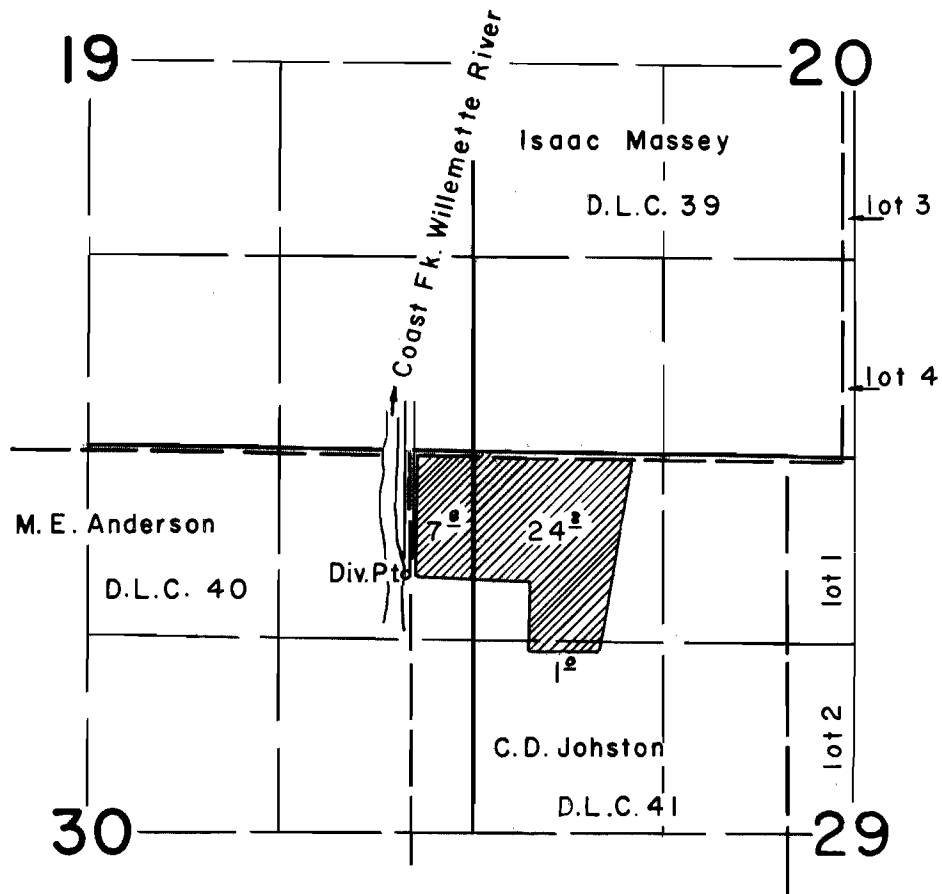


FINAL PROOF SURVEY
UNDER

Application No. 33324 Permit No. 26487
IN NAME OF

Murry Newton

Surveyed May 7 1963, by C. Baker

T. 22 S. R. 3 W. W.M.

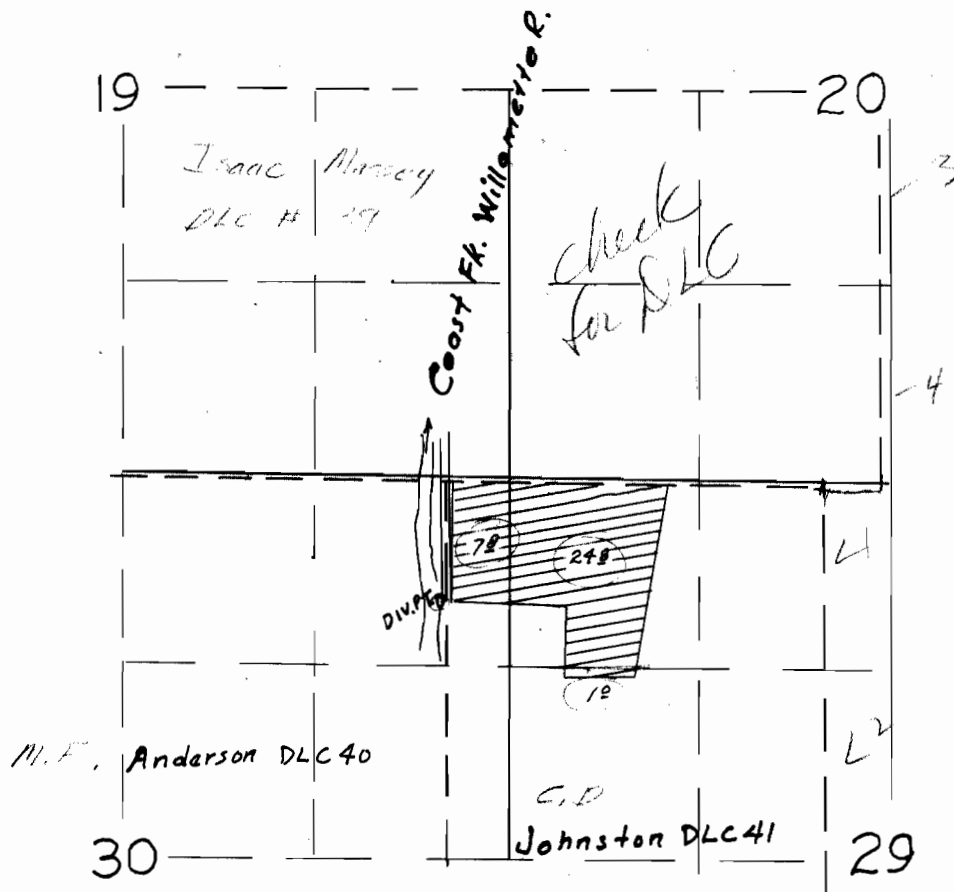

FINAL PROOF SURVEY
UNDER

Application No. 33324 Permit No. 26487
IN NAME OF

Murry Newton

Surveyed 5-7 1963, by C. Baker