


T.17S. R.12 W. W.M.

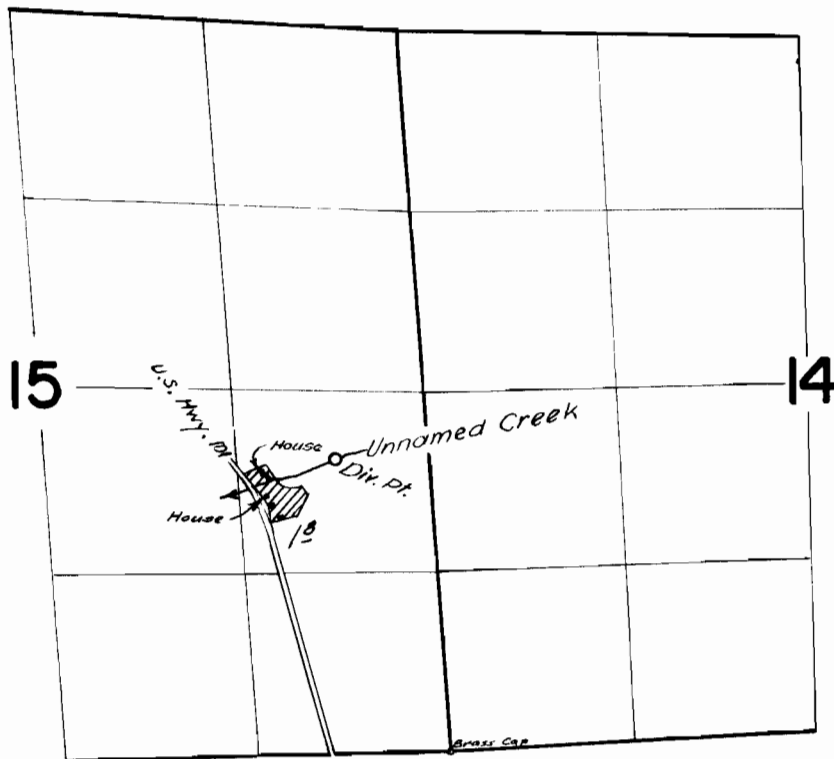

FINAL PROOF SURVEY
UNDER

Application No. **34156** Permit No. **26910**
IN NAME OF

EMIL SKOOG

Surveyed June 24 & 26 1963, by

R. V. Jackson