


T.17S.R.1E.W.M.

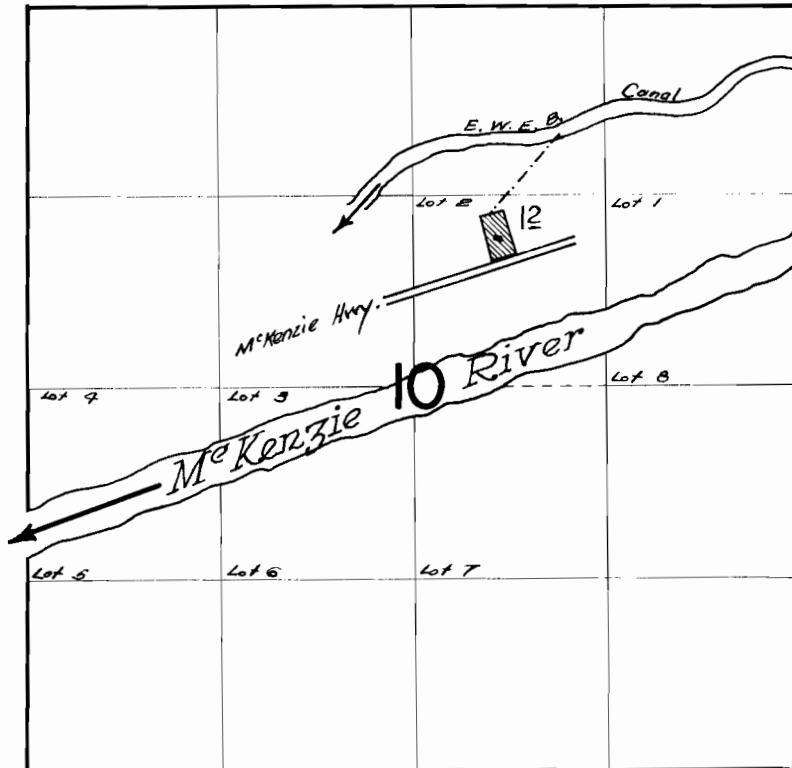

**FINAL PROOF SURVEY**  
UNDER

Application No. 37297... Permit No. 27778...  
IN NAME OF

..... E. W. HOWELLS .....

Surveyed May 9, 1963, by C. Baker.....