


T.17S.R.2W.W.M.

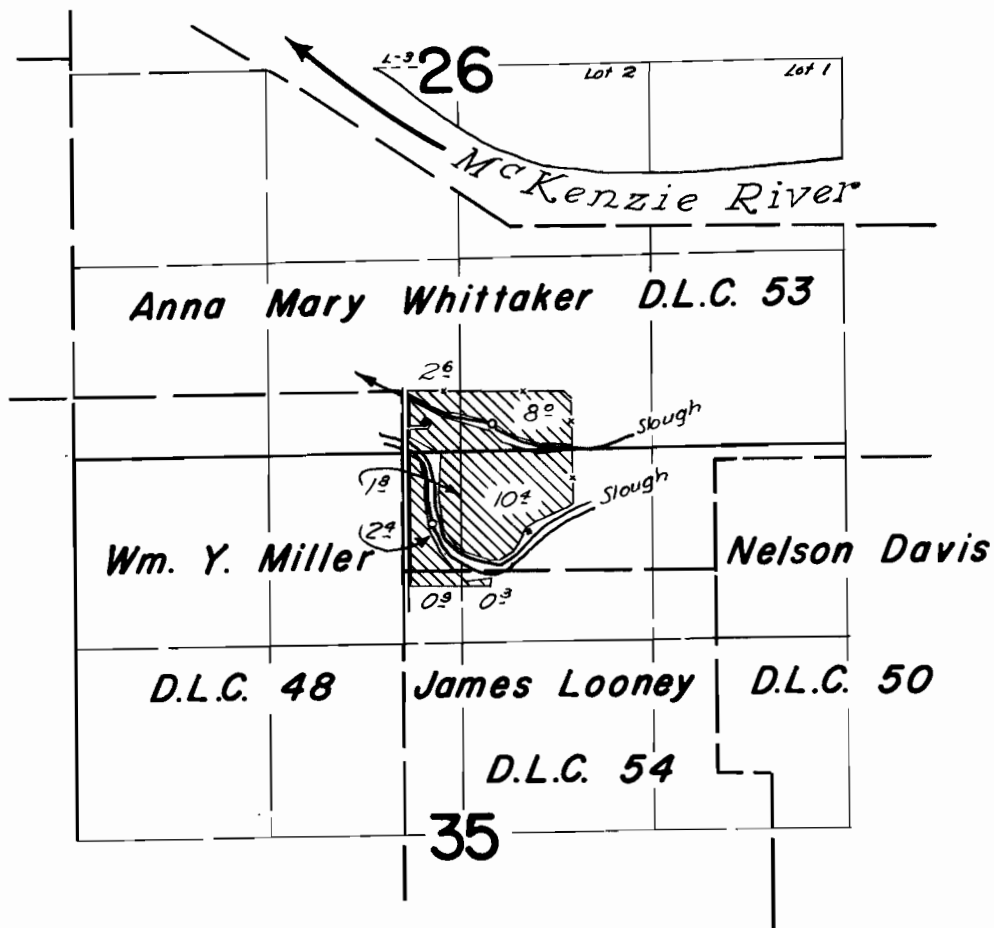

FINAL PROOF SURVEY
UNDER

Application No. **37409** Permit No. **27935**
IN NAME OF

GLORIA J. OLSON

Surveyed *May 7* 1963, by *R. Jackson*