


# T.5S.R.1W.W.M.

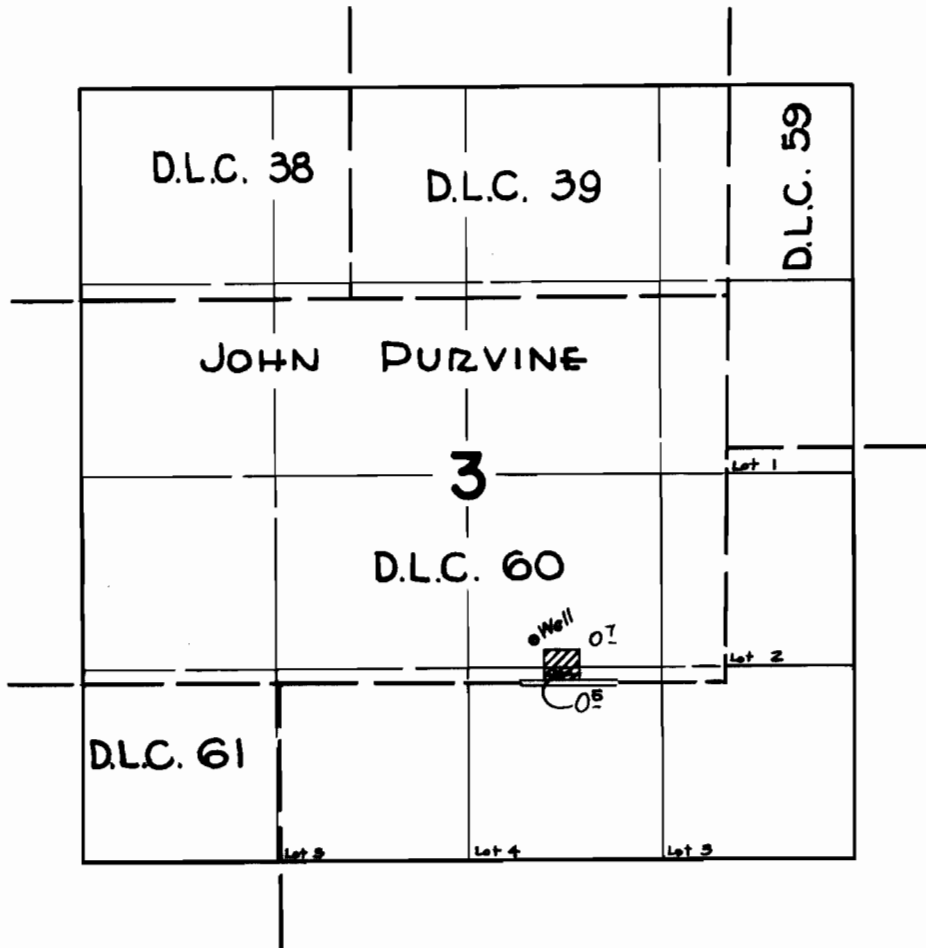

## FINAL PROOF SURVEY UNDER

Application No. G-1566. Permit No. G-1448.  
IN NAME OF

JULIUS ZAMLO

Surveyed April 22 1963, by T. LAUER

AT