


T.5S.R.1W.W.M.

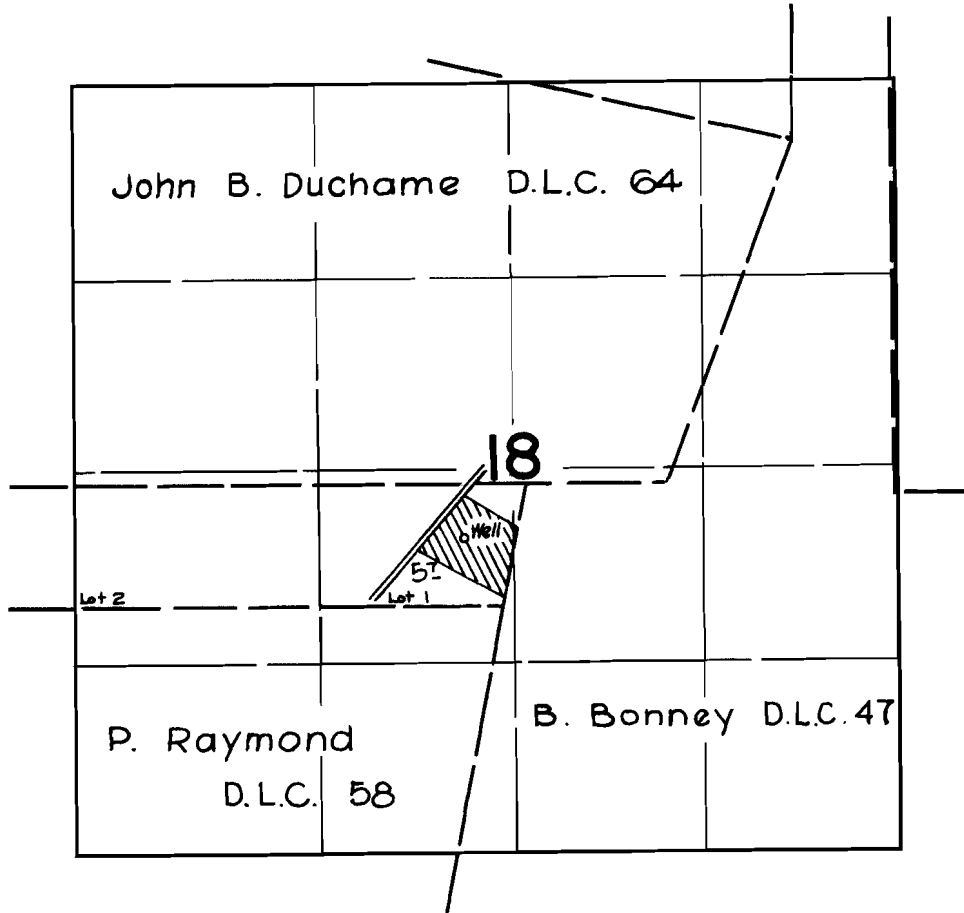

FINAL PROOF SURVEY
UNDER

Application No. G-1634 Permit No. G-1514
IN NAME OF

EDGAR T. BROWN

Surveyed April 16 1963, by T. LAUER

RL