


T.6S.R.1&2W.W.M.

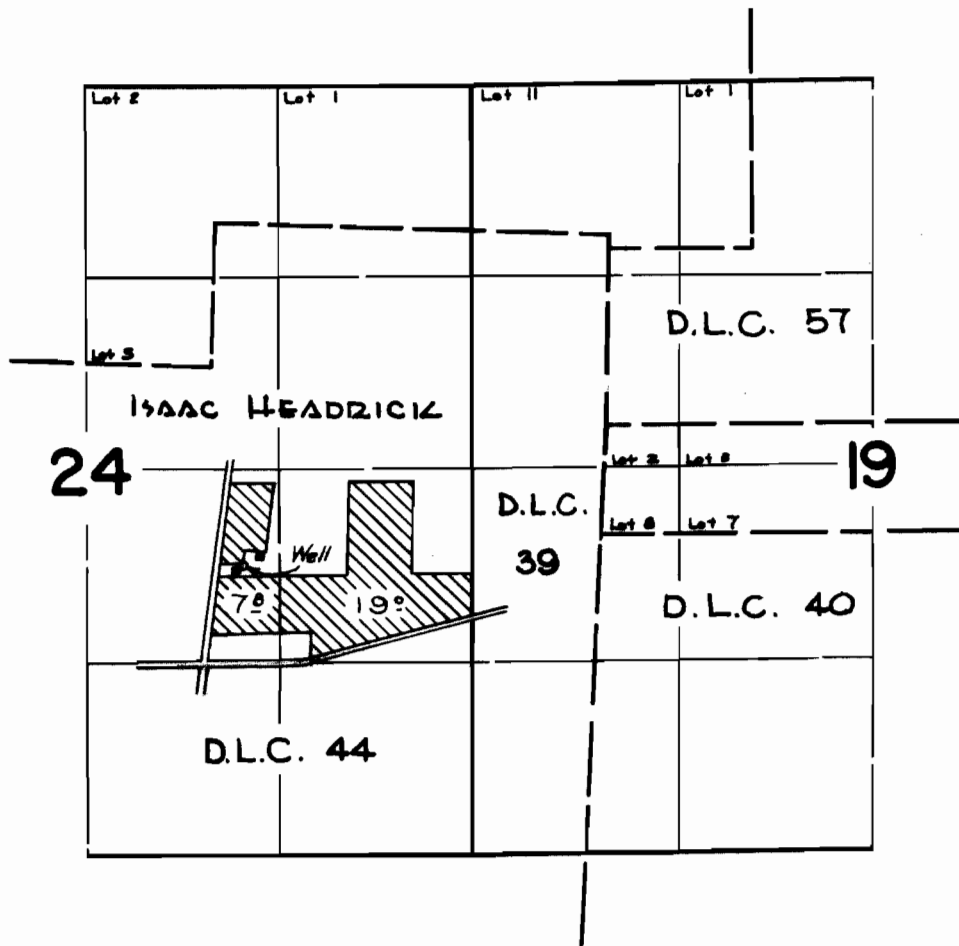

FINAL PROOF SURVEY UNDER

Application No. G-1789 Permit No. G-1610
IN NAME OF

CONRAD GUNDERSON

Surveyed April 26 1963, by T. LAUER