


T. 9 S. R. 1 W. W. M

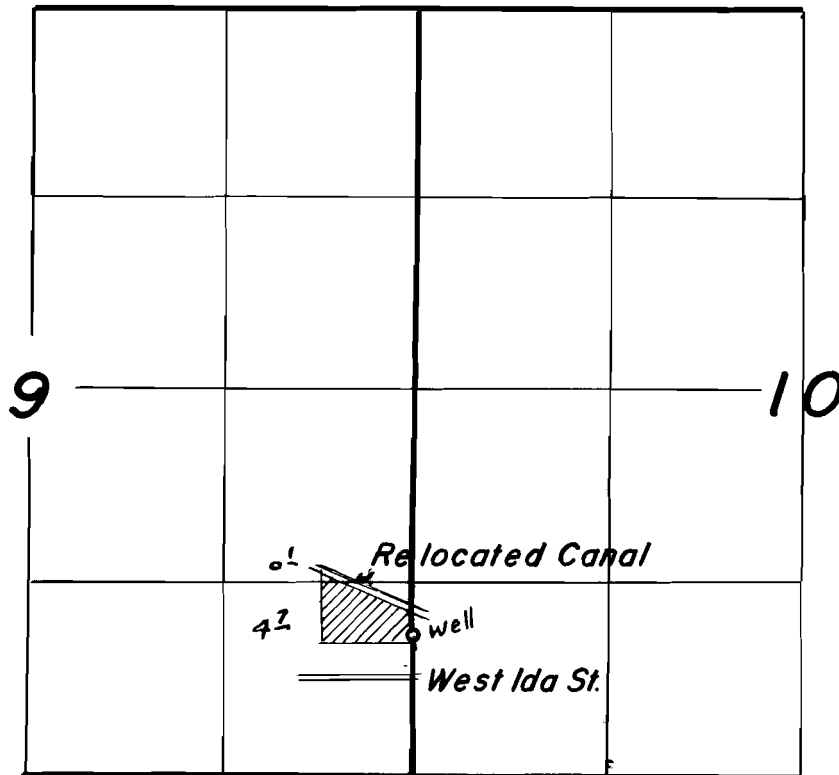

FINAL PROOF SURVEY
UNDER

Application No. *G-1870* Permit No. *G-1772*
IN NAME OF

Matthies J. Mack.....

Surveyed *June 22 1964*, by *Siegmund*.....