


T.6S.R.1W.W.M.

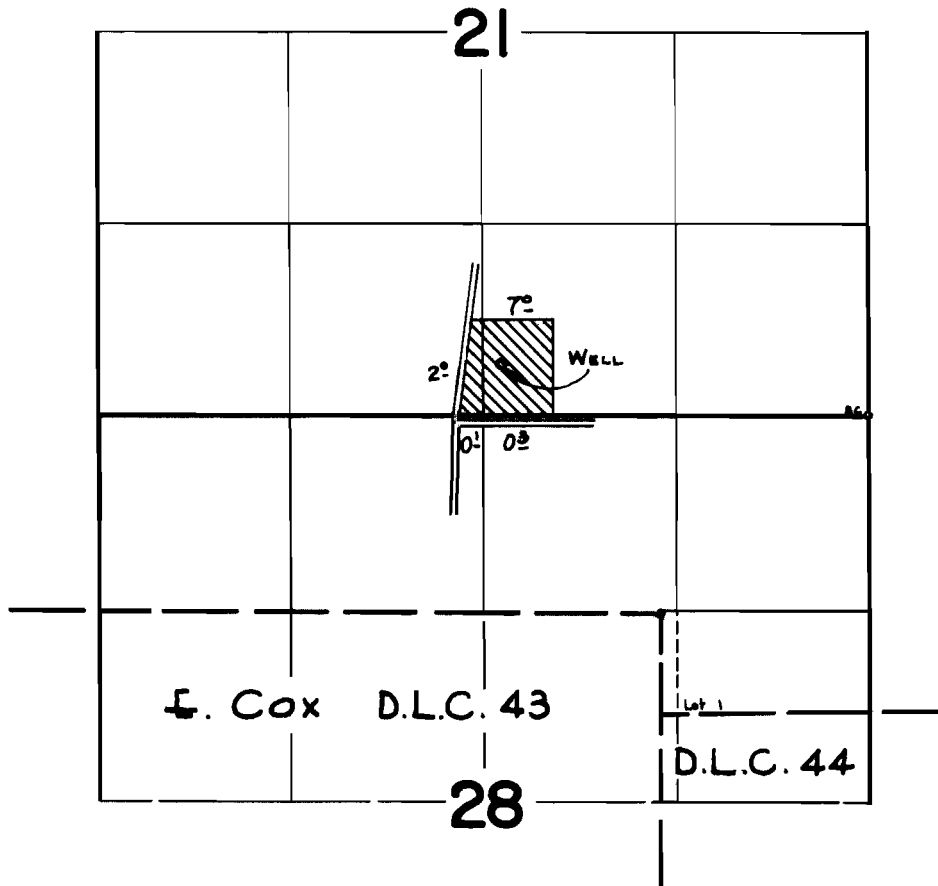

FINAL PROOF SURVEY UNDER

Application No. G-2514 Permit No. G-2322
IN NAME OF

H. C. BANKS

Surveyed Oct. 25 1963, by T. LAUER