


T. 9 S. R. 1 W. W.M.

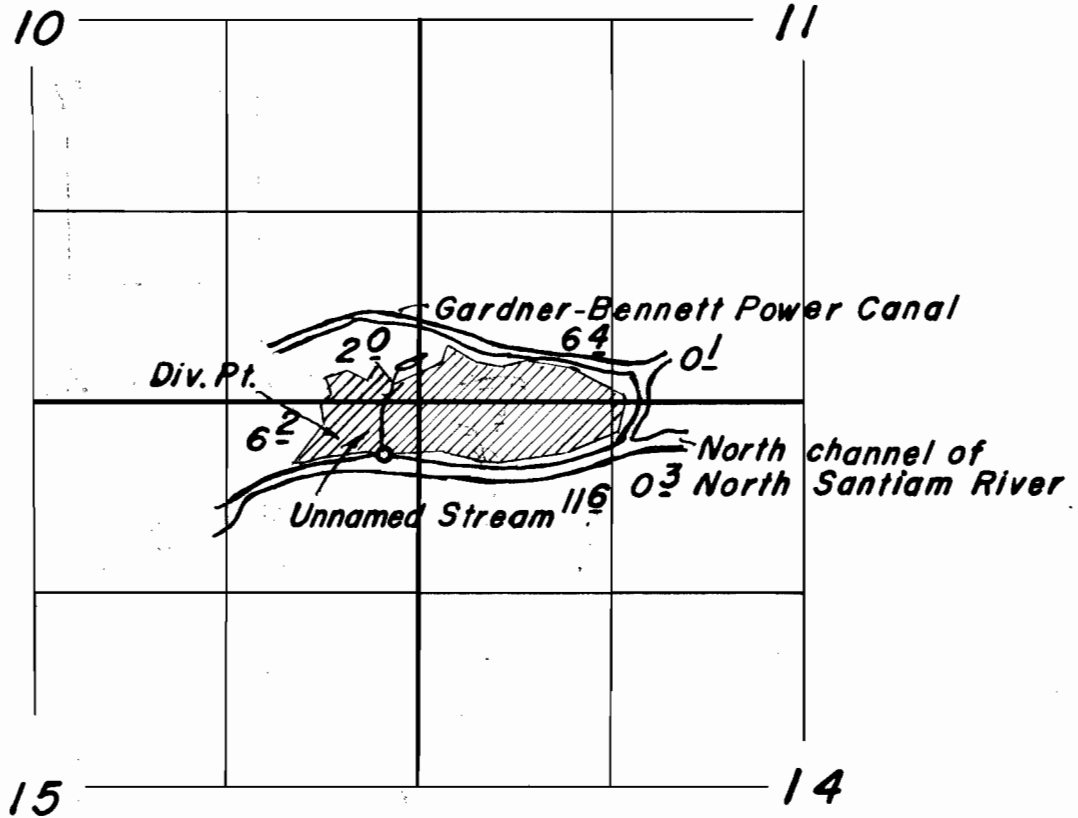

FINAL PROOF SURVEY
UNDER

Application No. 39076 Permit No. 29170
IN NAME OF

David M. Reid

Surveyed July 11, 1963, by Floyd L. Siegmund