


T.2N.R.29E.W.M.

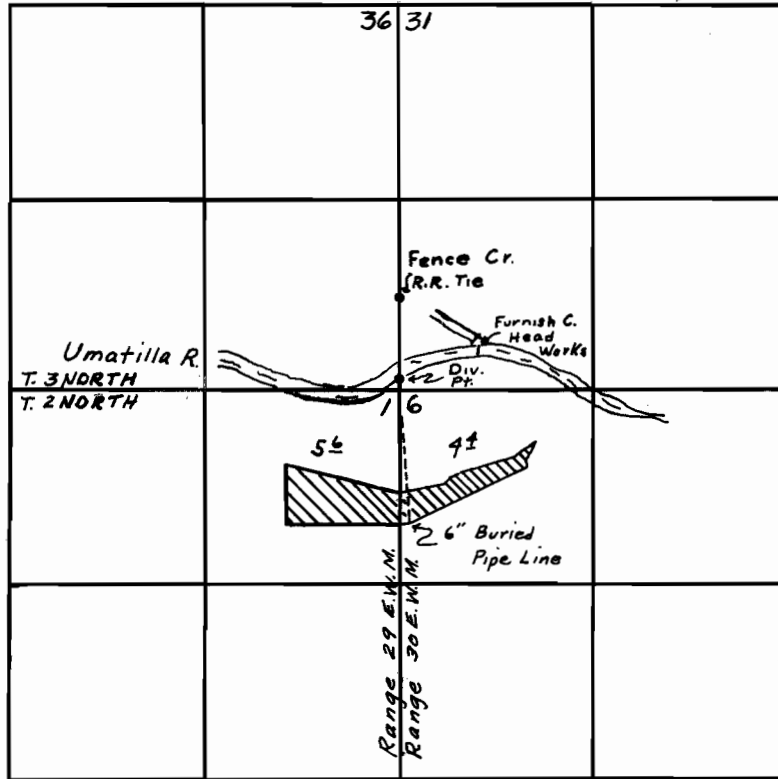

FINAL PROOF SURVEY  
UNDER

APPLICATION NO. 29197 . . PERMIT NO. 25222 .  
IN NAME OF

FRANCES FARO

SURVEYED FEB. 28, 1964 by *Jimmy F. Haines*