T.5 S. R.39 E.W.M.

FINAL PROOF SURVEY

UNDER

Application No. R-29501 Permit No. R-1810
29502 23934

IN NAME OF

JOHN A. SHAW
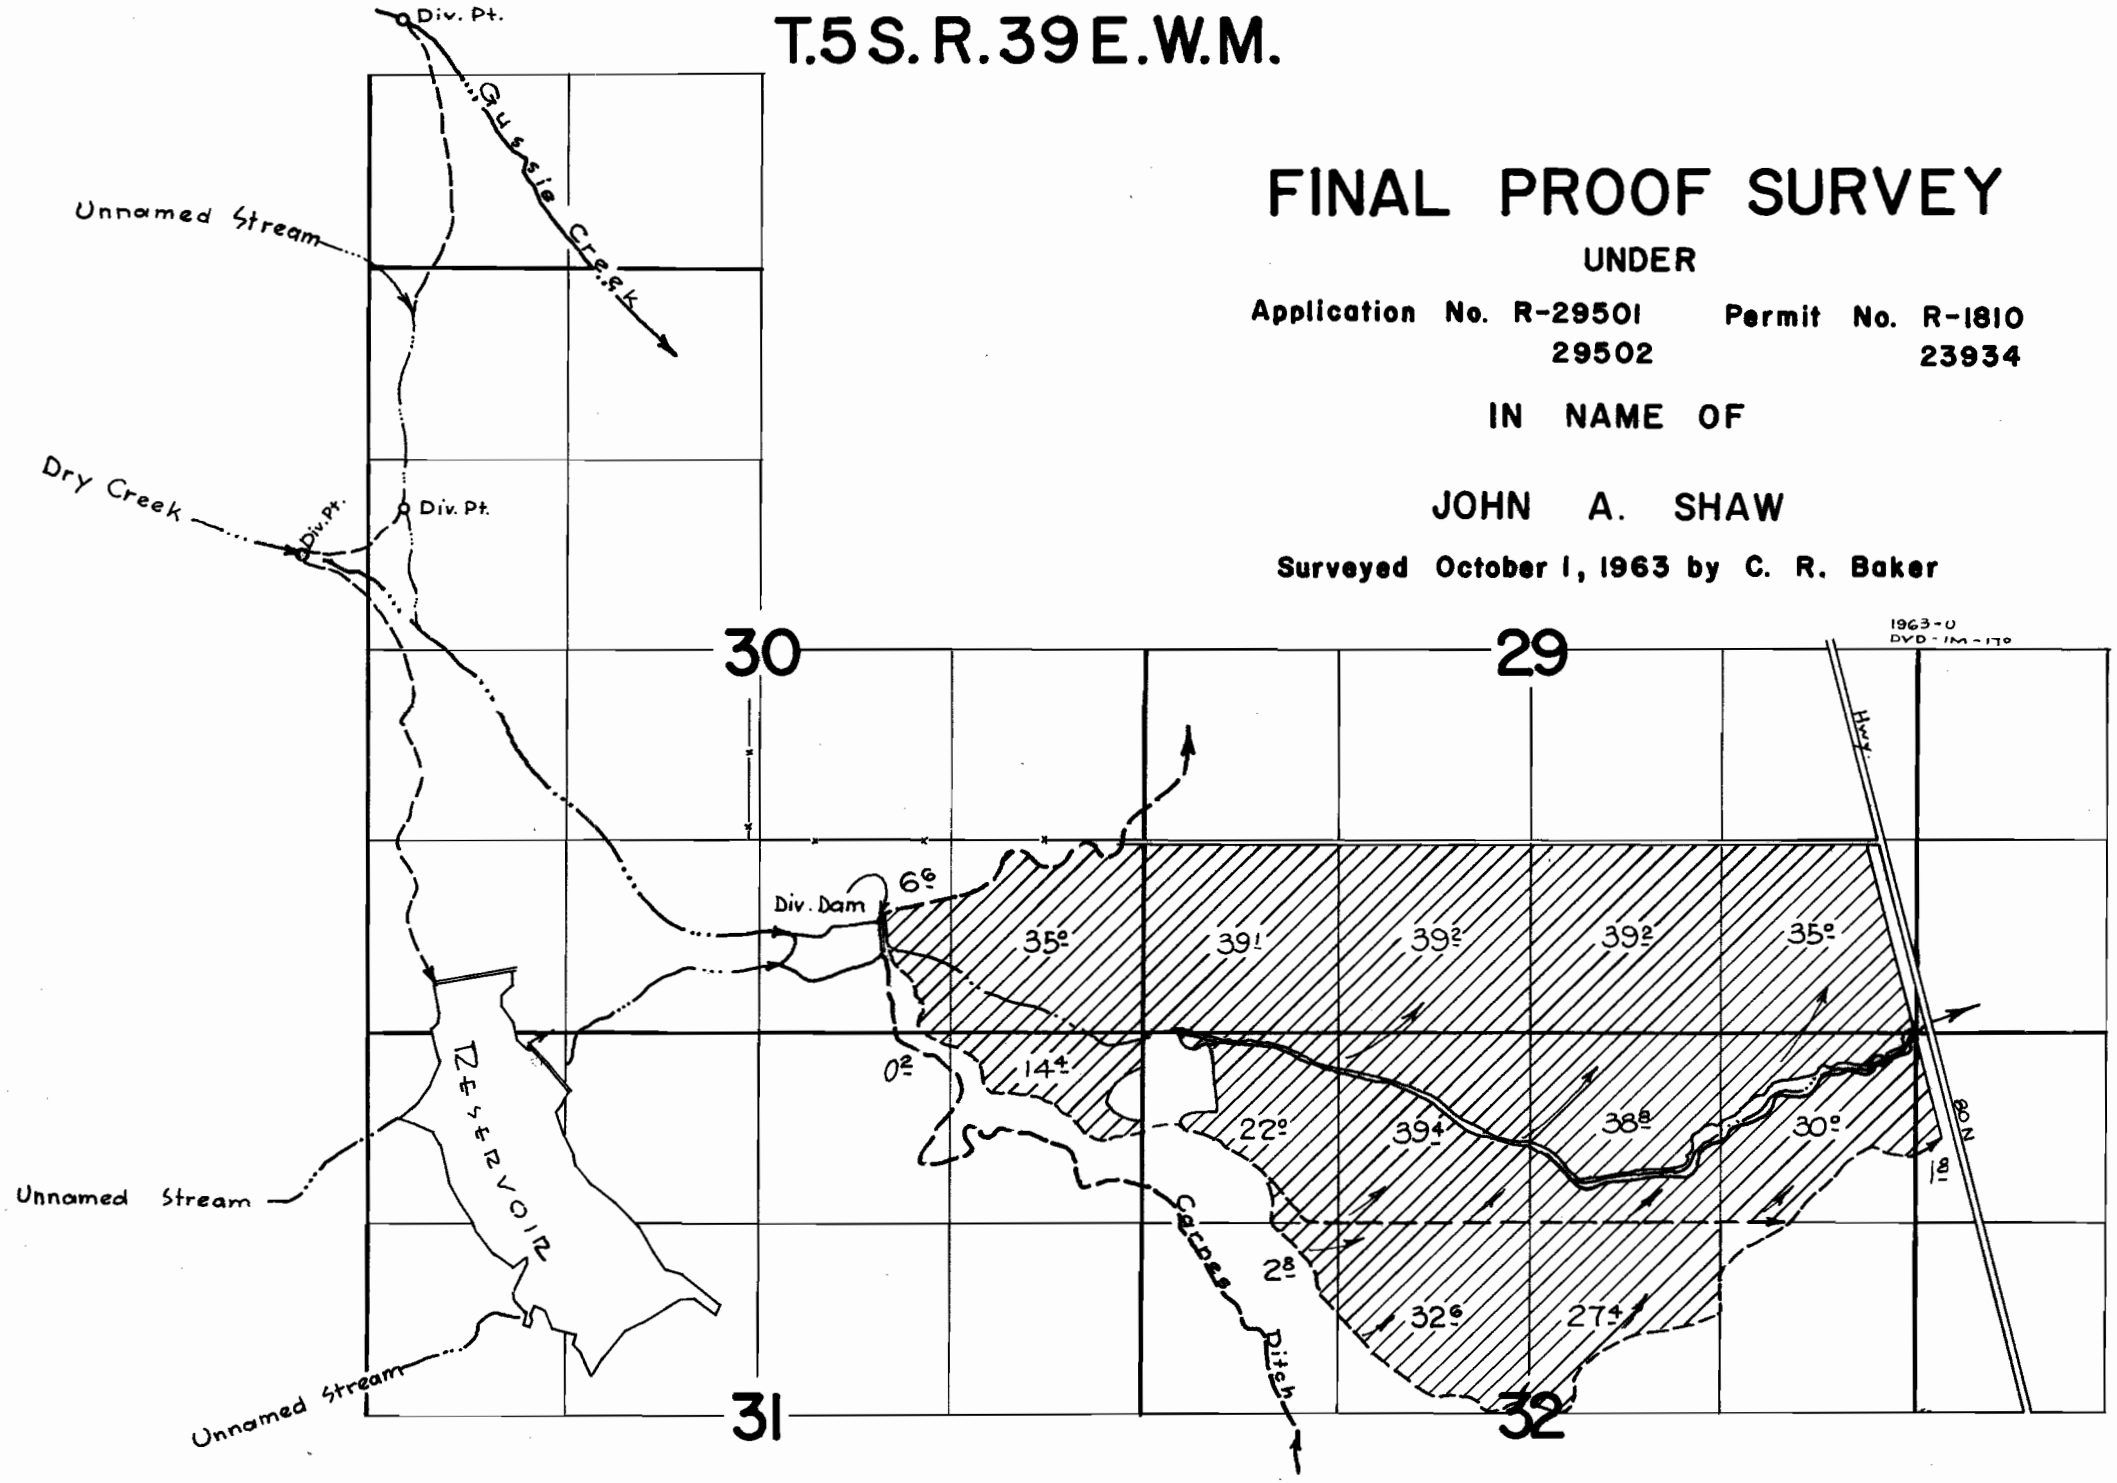
Surveyed October 1, 1963 by C. R. Baker