

T.5S.R.39E.W.M.

FINAL PROOF SURVEY

UNDER


Application No. R-29501
29502

Permit No. R-1810
23934

IN NAME OF

JOHN A. SHAW

Surveyed October 1, 1963 by C. R. Baker

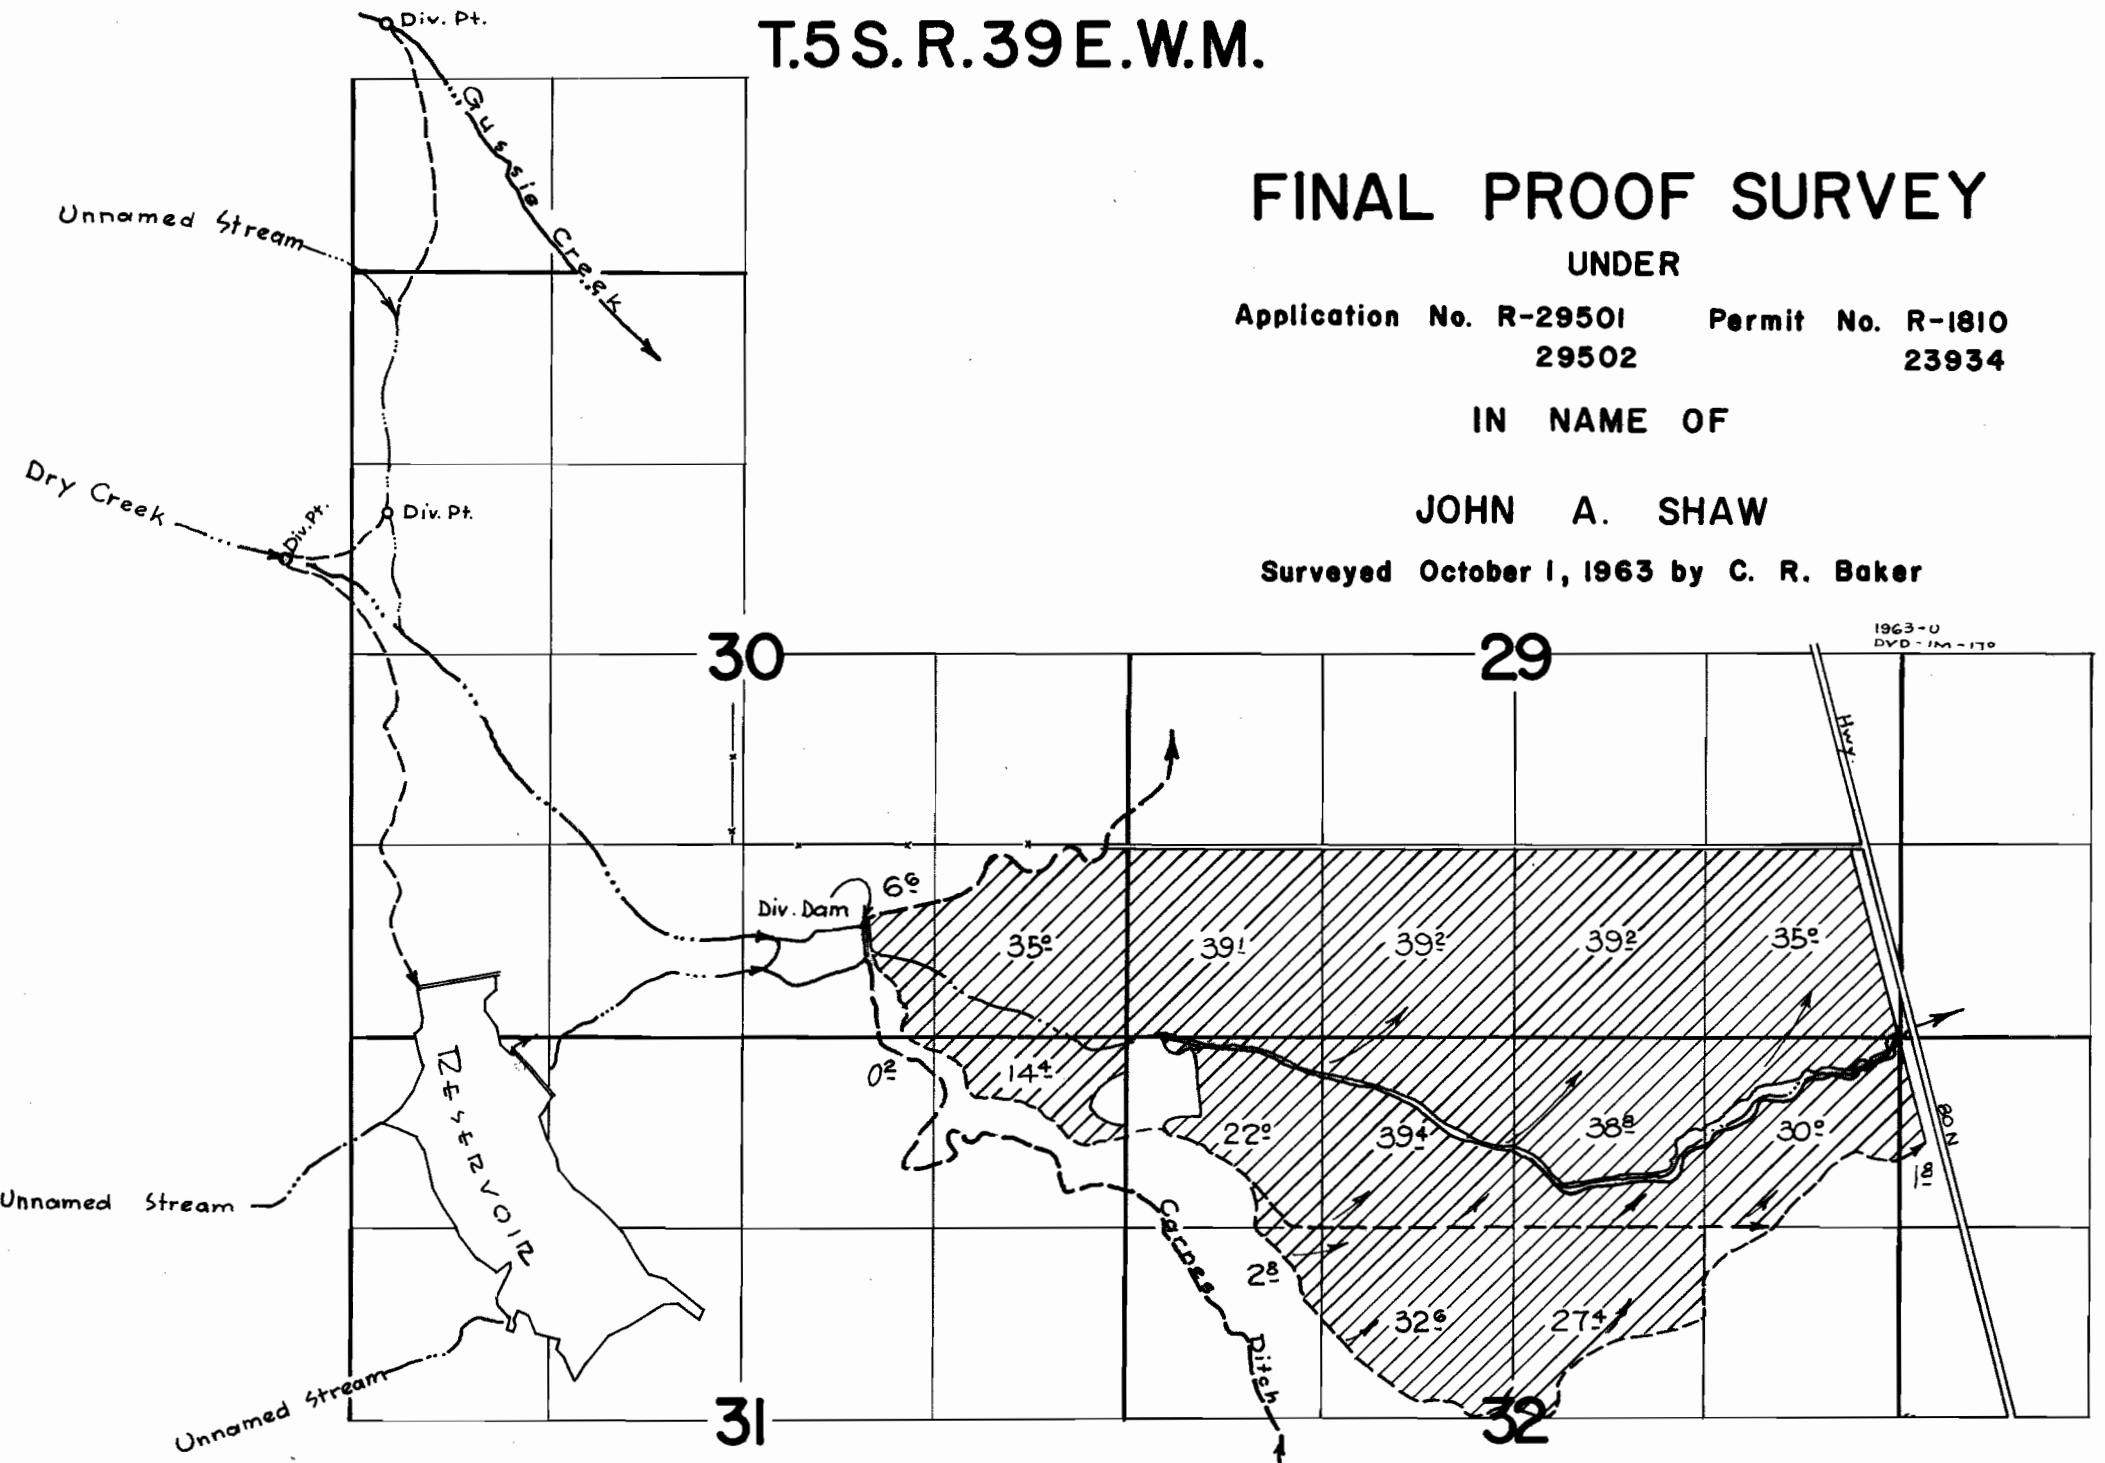

1963-0
DVD-1M-170