


T. 2 N. R. 12 E. W. M.

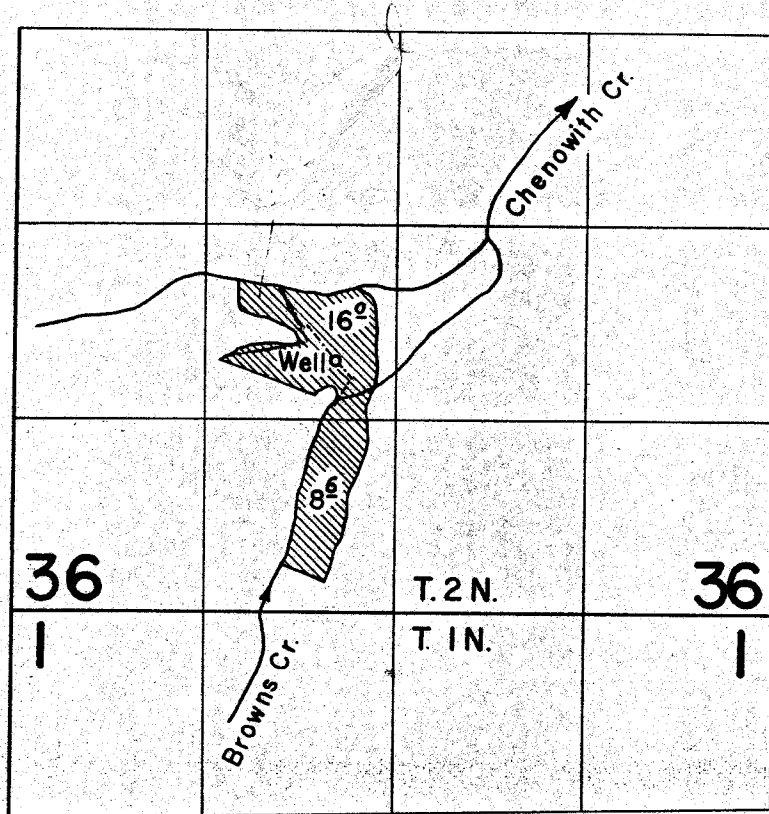

**FINAL PROOF SURVEY**  
UNDER

Application No. G-3..... Permit No. G-178.....  
IN NAME OF

Karl F. Thomsen

Surveyed April 8..... 1963, by *L.W. Jelousek*