


G-15875

# T. 1 N. R. 15 E. W.M.

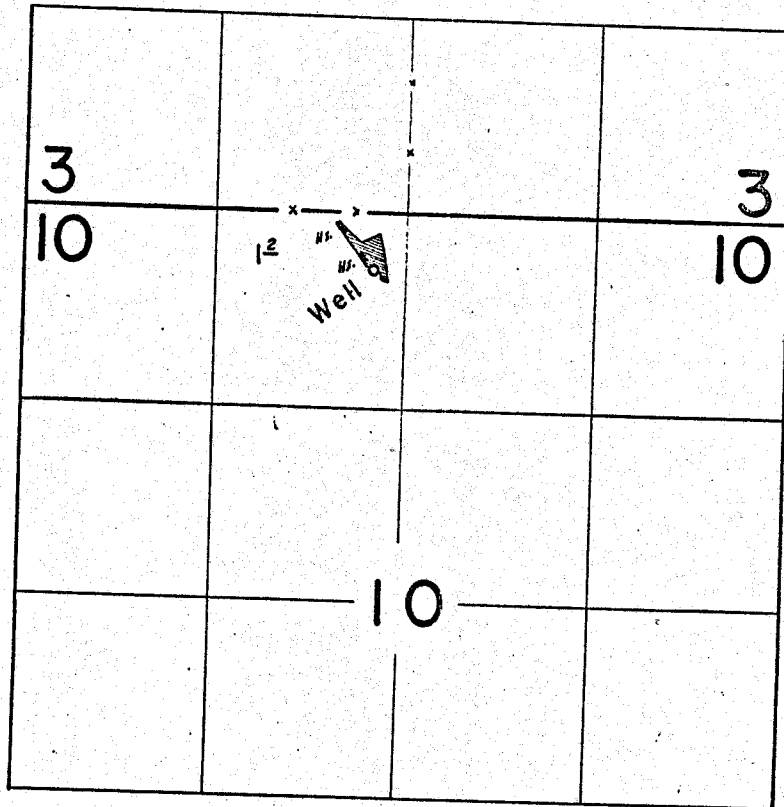

## FINAL PROOF SURVEY UNDER

Application No. G-1738... Permit No. G-1587...  
IN NAME OF

.....LELAND M. FULTON.....

Surveyed March 26 1963, by *Larry Johnson*

Dist. 3 1963-A