


T. 1 S. R. 12 E. W. M.

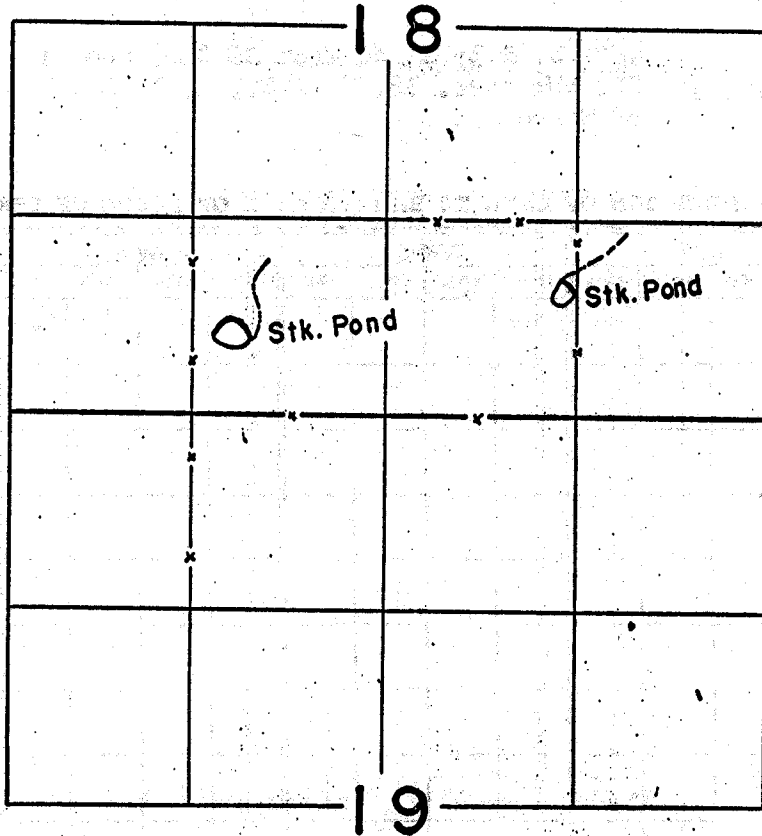

FINAL PROOF SURVEY
UNDER

R-31612

R-2097

31820

25231

R-33522

R-2311

Application No. 33515..... Permit No. 26509...

IN NAME OF

.....CLARENCE L. GRAY.....

Surveyed March 28 1963, by *Larry J. Goussard*