


T. 1 S. R. 13 E. W.M.

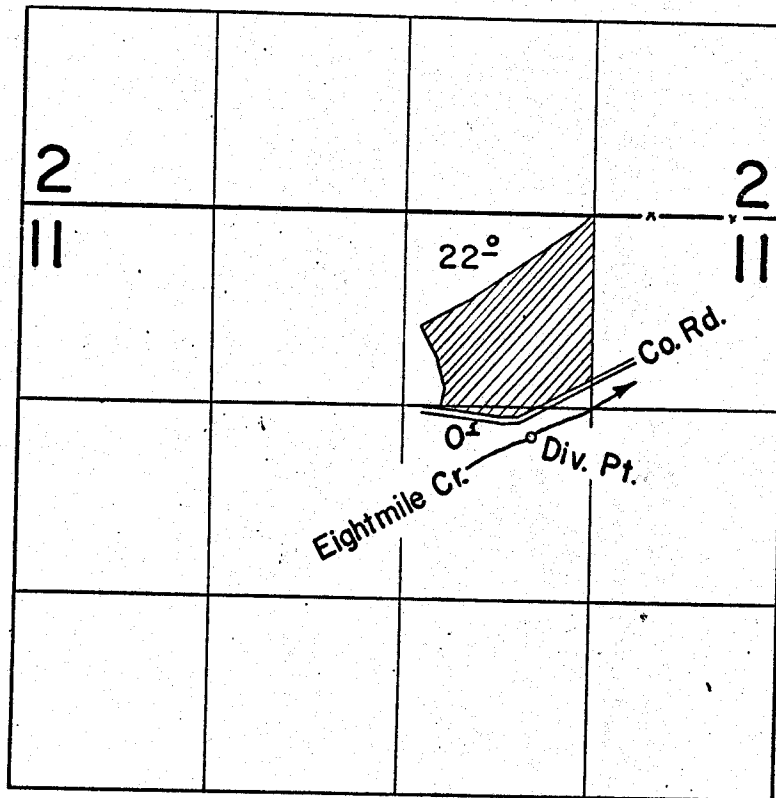

FINAL PROOF SURVEY
UNDER

Application No. 34801... Permit No. 27336..
IN NAME OF

THOMAS W. DAVIDSON

Surveyed March 29 1963, by *Larry J. House*