


T. 1 N. R. 13 E. W. M.

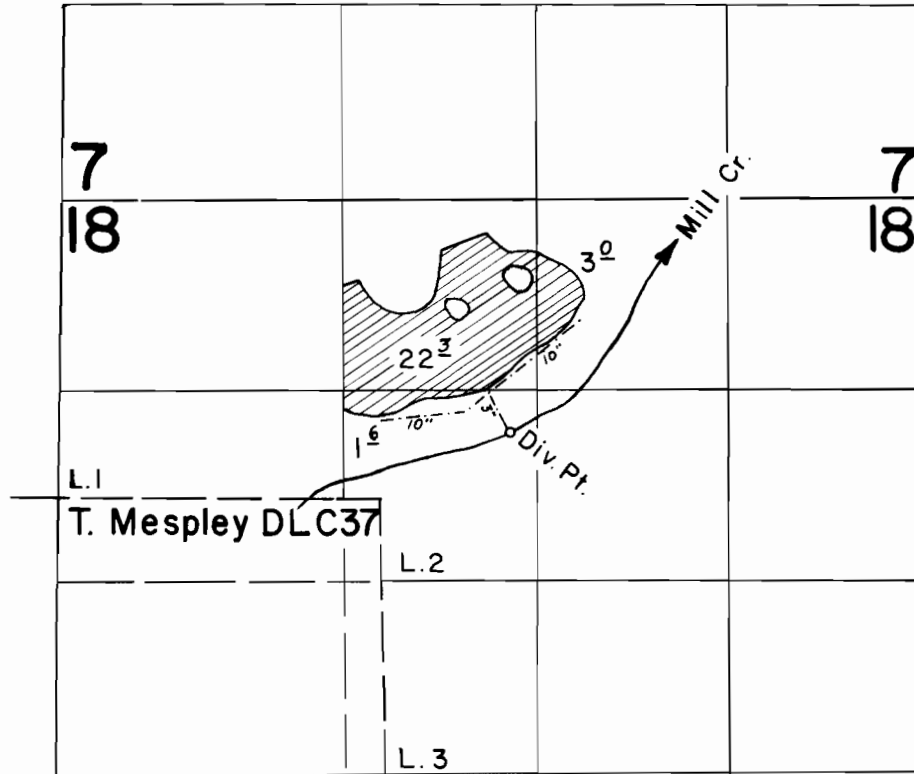

FINAL PROOF SURVEY
UNDER

Transfer No. M-143
Application No. 37973 Permit No. 28315
IN NAME OF

..... **JOHN McCOLLOM**

Surveyed April 2, 1963, by *Louise J. Jelousek*