


T.3S.R.2 W.W.M.

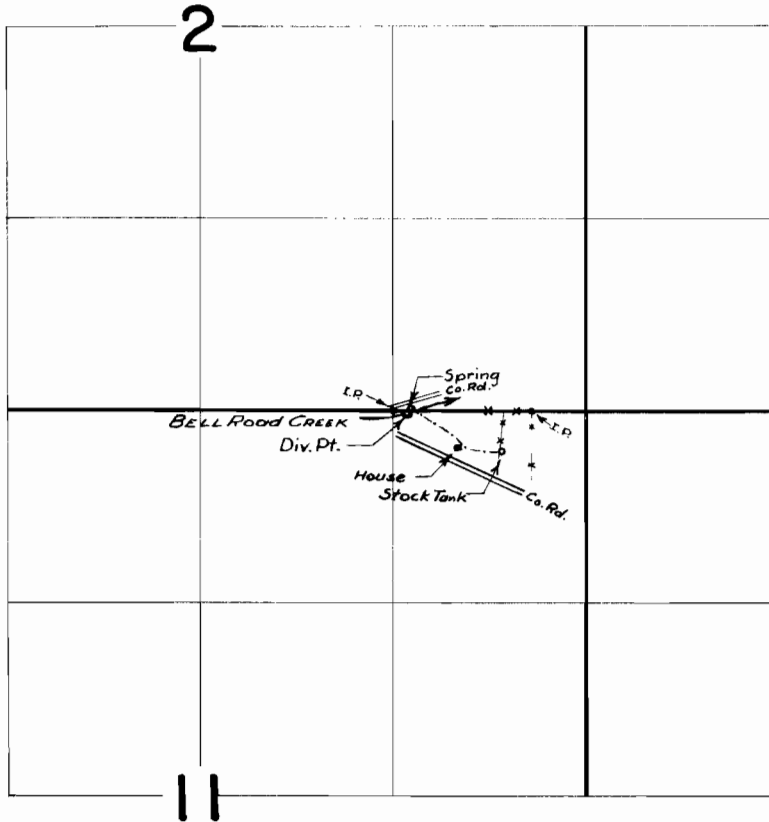

FINAL PROOF SURVEY

UNDER

Application No. 34269 Permit No. 26967
IN NAME OF

HAROLD M. NIXON

Surveyed Aug. 1, 1962, by M. Bish