


# T.3S.R.1W.W.M.

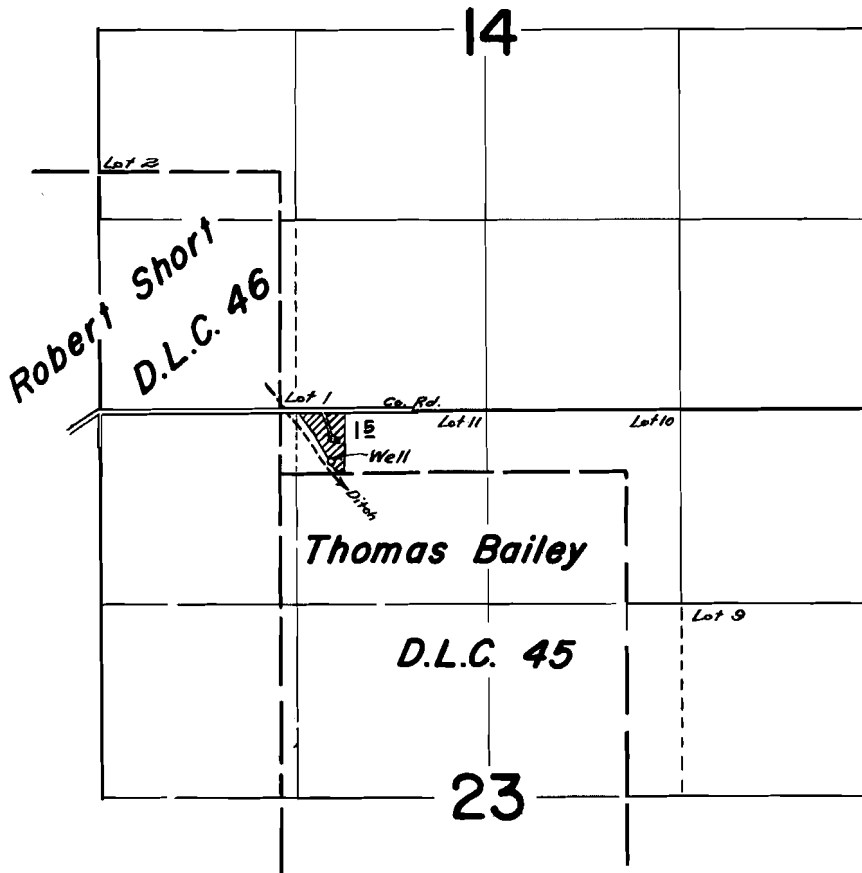

## FINAL PROOF SURVEY UNDER

Application No. G-1682... Permit No. G-1544...  
IN NAME OF

**FRANK BING LEE**

Surveyed May 3, 1963, by

*[Handwritten Signature]*