


T.4S.R.1E.W.M.

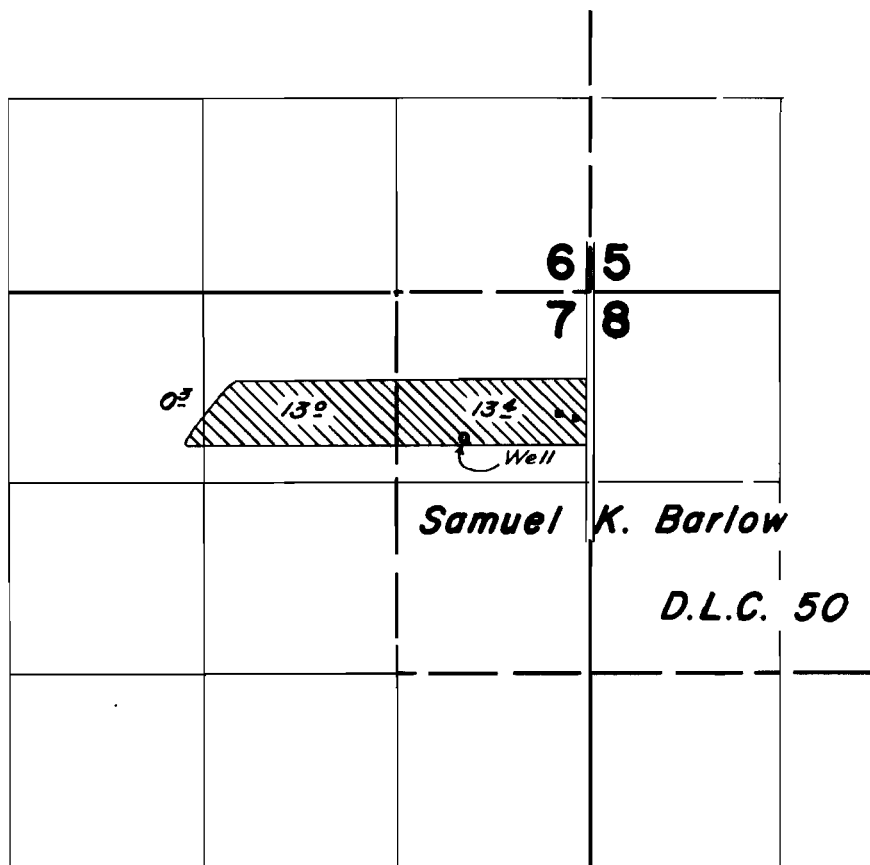

FINAL PROOF SURVEY
UNDER

Application No. G-1854 Permit No. G-1696
IN NAME OF

FRANK WROBLE

Surveyed April 15 1963, by [Signature]