


T.4S.R.1E.W.M.

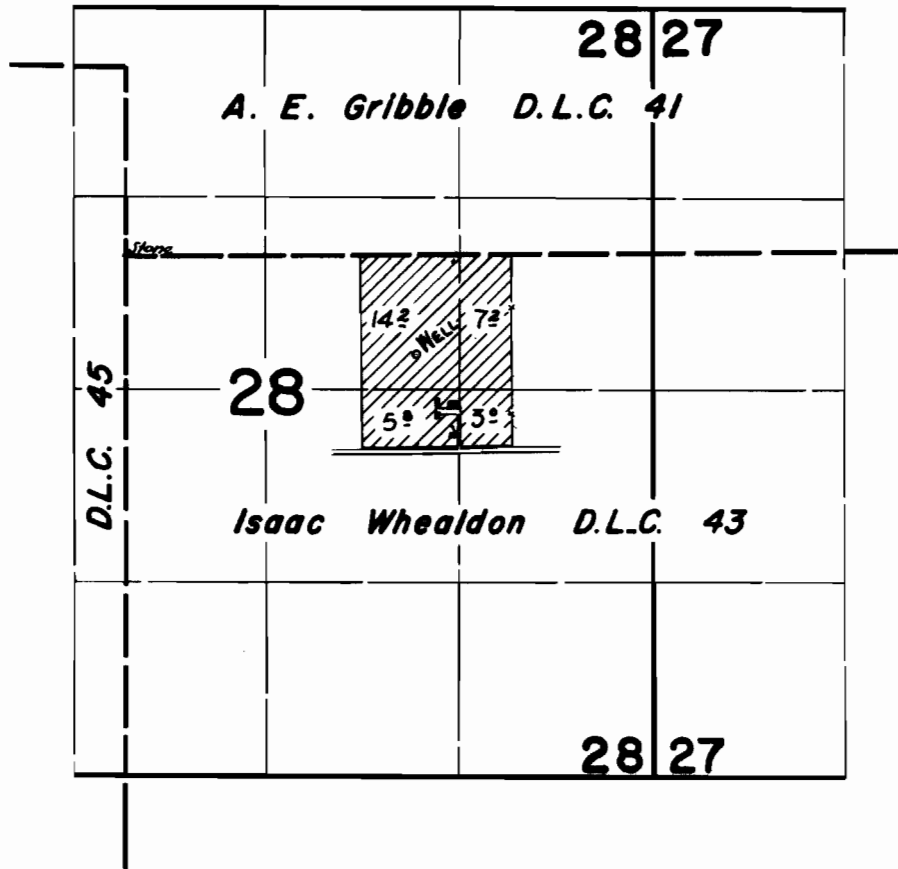

FINAL PROOF SURVEY UNDER

Application No. G-2162. Permit No. G-2167.
IN NAME OF

TITUS RAMER

Surveyed April 2, 1963, by

Alpheson